

GRANT COUNTY CLERK
RECEIVED

6th STREET

FEB 22 1985

PLAT OF SURVEY

FOR: GRANTLAND F.S.
% MR. JOHN SYLER
HWY '61' NORTH
LANCASTER, WI.


LEGEND

- EXISTING 1" ROUND, IRON PIPE FOUND
- 1" x 24" (min.) ROUND, IRON PIPE SET
- 1/2" SQUARE x 8" SOLID SPIKE SET IN PAVEMENT
- () RECORDED AS

NOTE : Bearings are referenced to the West line of the Northeast 1/4 of Section 19, which is recorded as bearing N 1°03'43" W.

AVENUE

LINCOLN

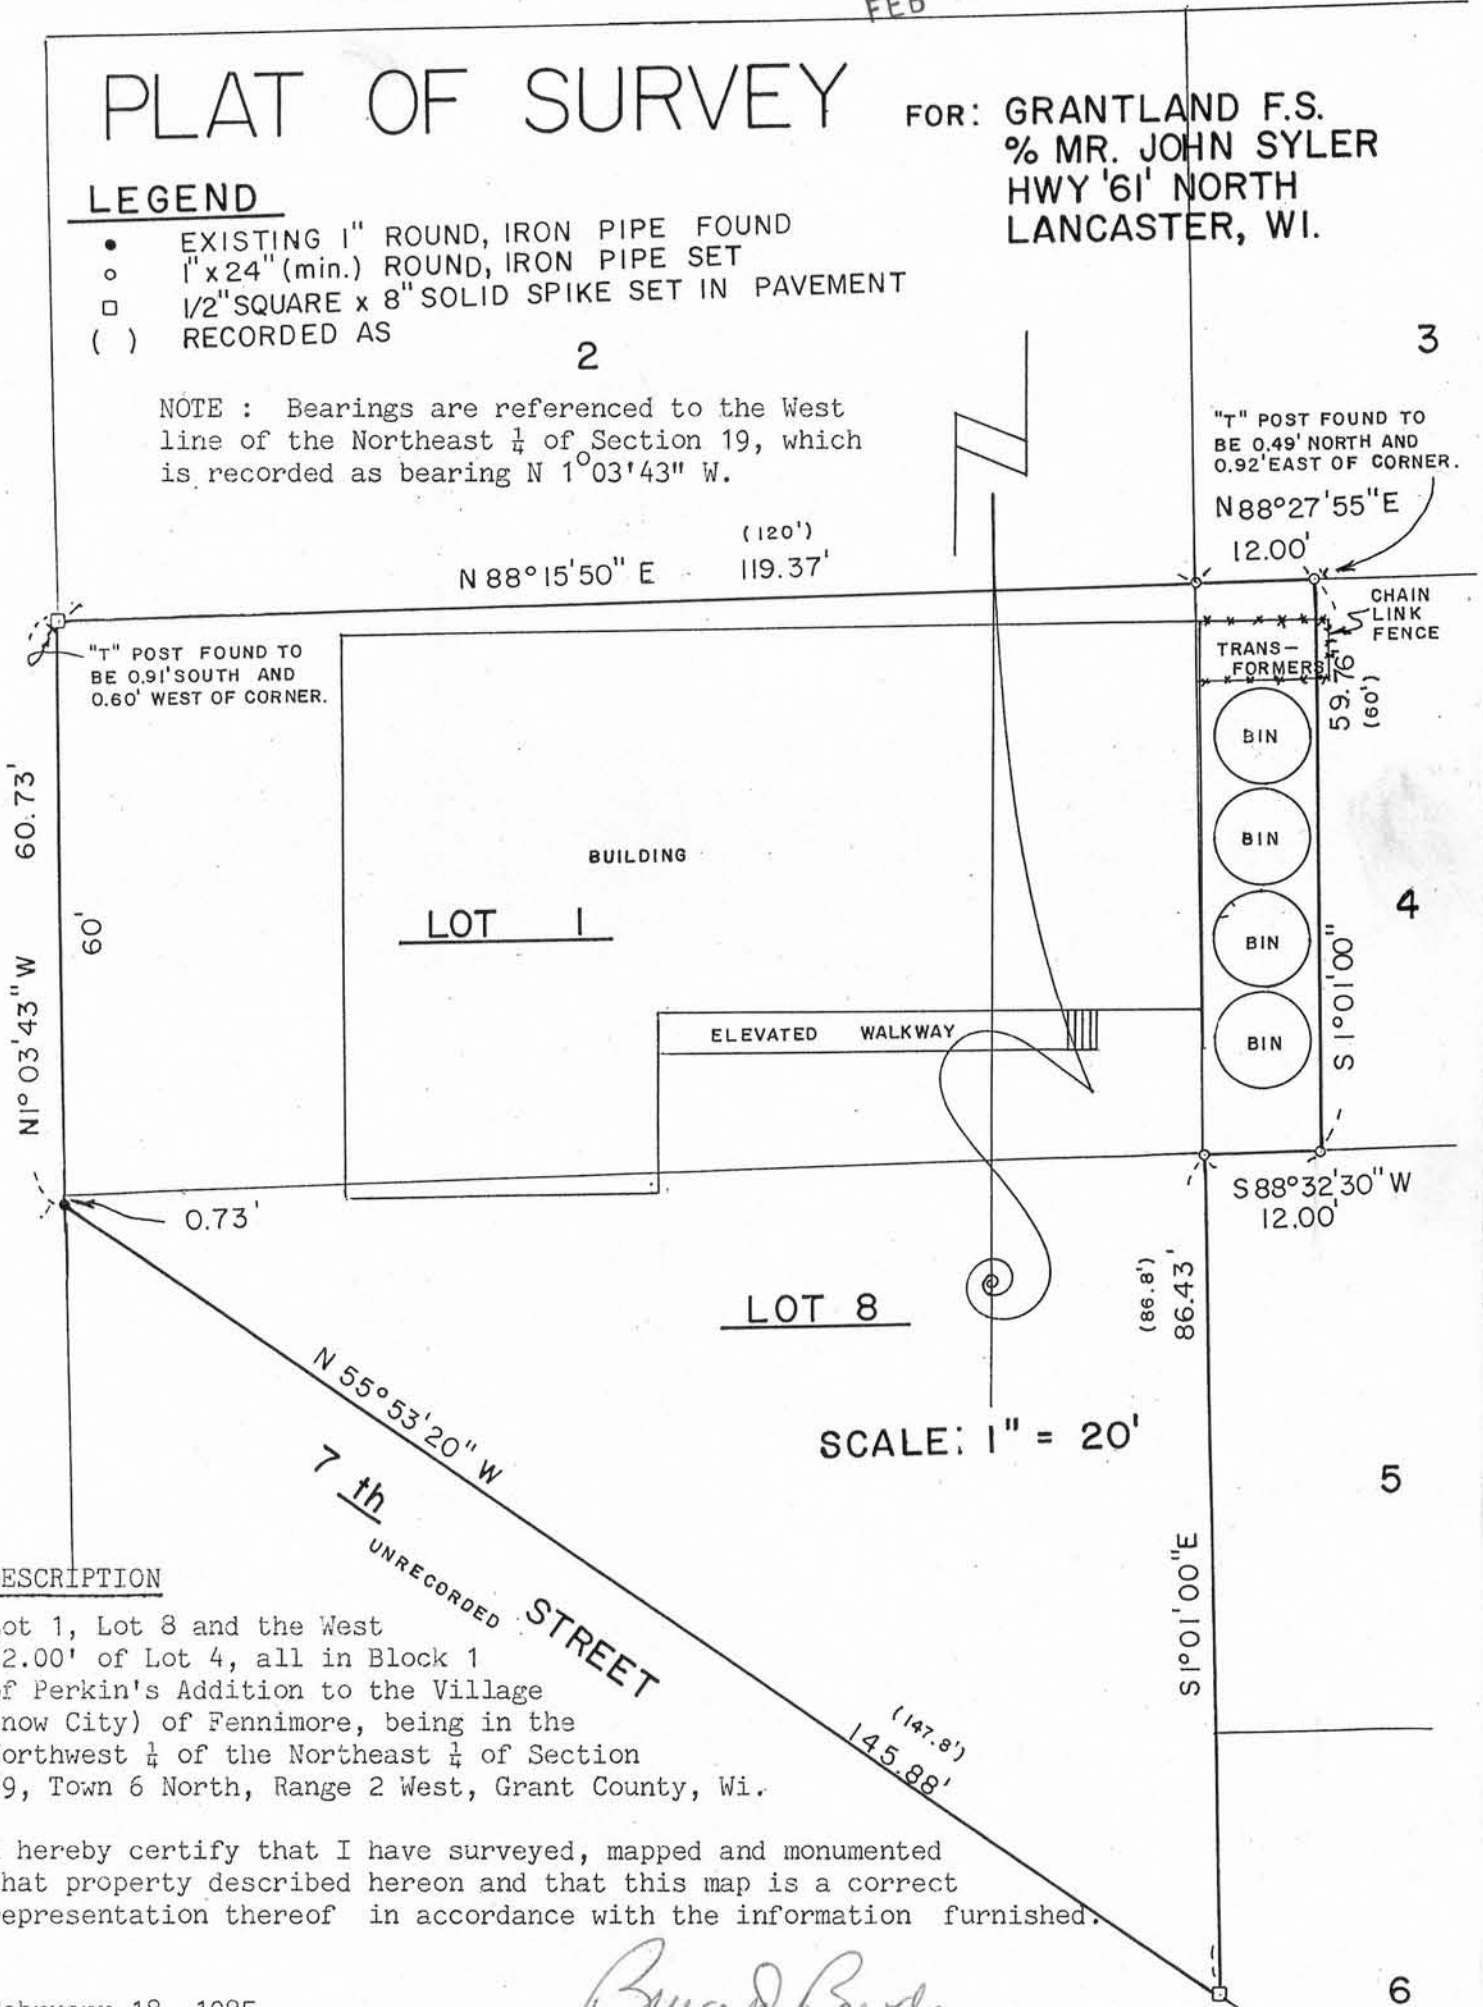

"T" POST FOUND TO BE 0.91' SOUTH AND 0.60' WEST OF CORNER.

"T" POST FOUND TO BE 0.49' NORTH AND 0.92' EAST OF CORNER.

N 88°27'55" E

12.00'

N 88°15'50" E (120') 119.37'

BUILDING

LOT 1

ELEVATED WALKWAY

TRANS-FORMER

59.76' (60')

BIN

BIN

BIN

BIN

S 1°01'00" E

12.00'

S 88°32'30" W

12.00'

LOT 8

(86.8') 86.43'

SCALE: 1" = 20'

N 55°53'20" W

7th STREET

UNRECORDED STREET

(147.8') 145.88'

S 1°01'00" E

DESCRIPTION

Lot 1, Lot 8 and the West 12.00' of Lot 4, all in Block 1 of Perkin's Addition to the Village (now City) of Fennimore, being in the Northwest 1/4 of the Northeast 1/4 of Section 19, Town 6 North, Range 2 West, Grant County, Wi.

I hereby certify that I have surveyed, mapped and monumented that property described hereon and that this map is a correct representation thereof in accordance with the information furnished.

February 18, 1985

Bruce D. Bowden

Bruce D. Bowden R.L.S. - 1250
704 North Main Street
Dodgeville, Wi. 53533
Phone (608) 935 - 5513

