

December 1, 1983


Village of Tennyson
Grant County, Wis.

Village Hall Property



SCALE: 1" = 40'

- ⊙ 1" x 24" IRON PIPE
- 1/2" x 1/2" x 9" IRON STAKE IN PAVEMENT
- x P-K NAIL IN PAVEMENT

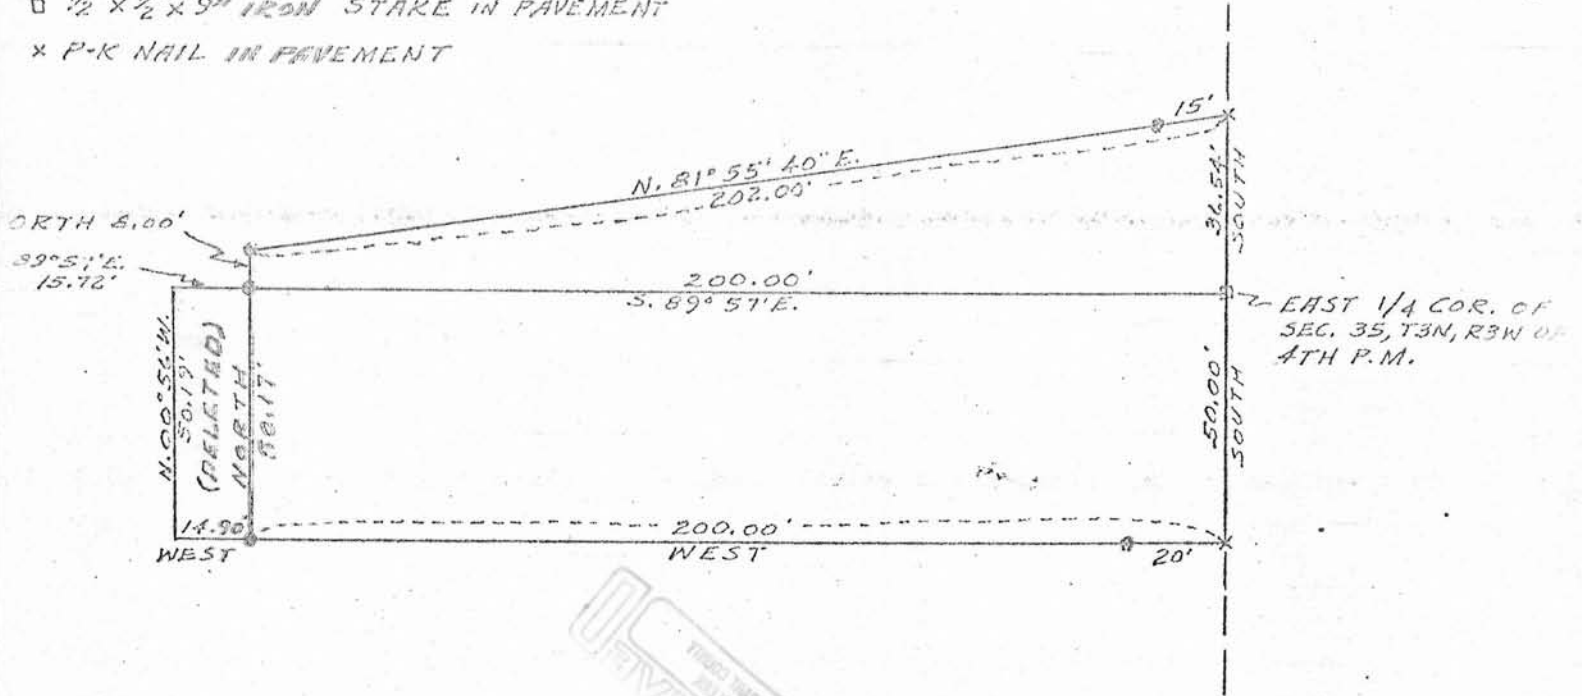

RECEIVED
JUL 8 1983

