


Sec. 34, T8N, R2W³ corrected 11-19

PLAT OF SURVEY FOR: CITY OF BOSCOBEL

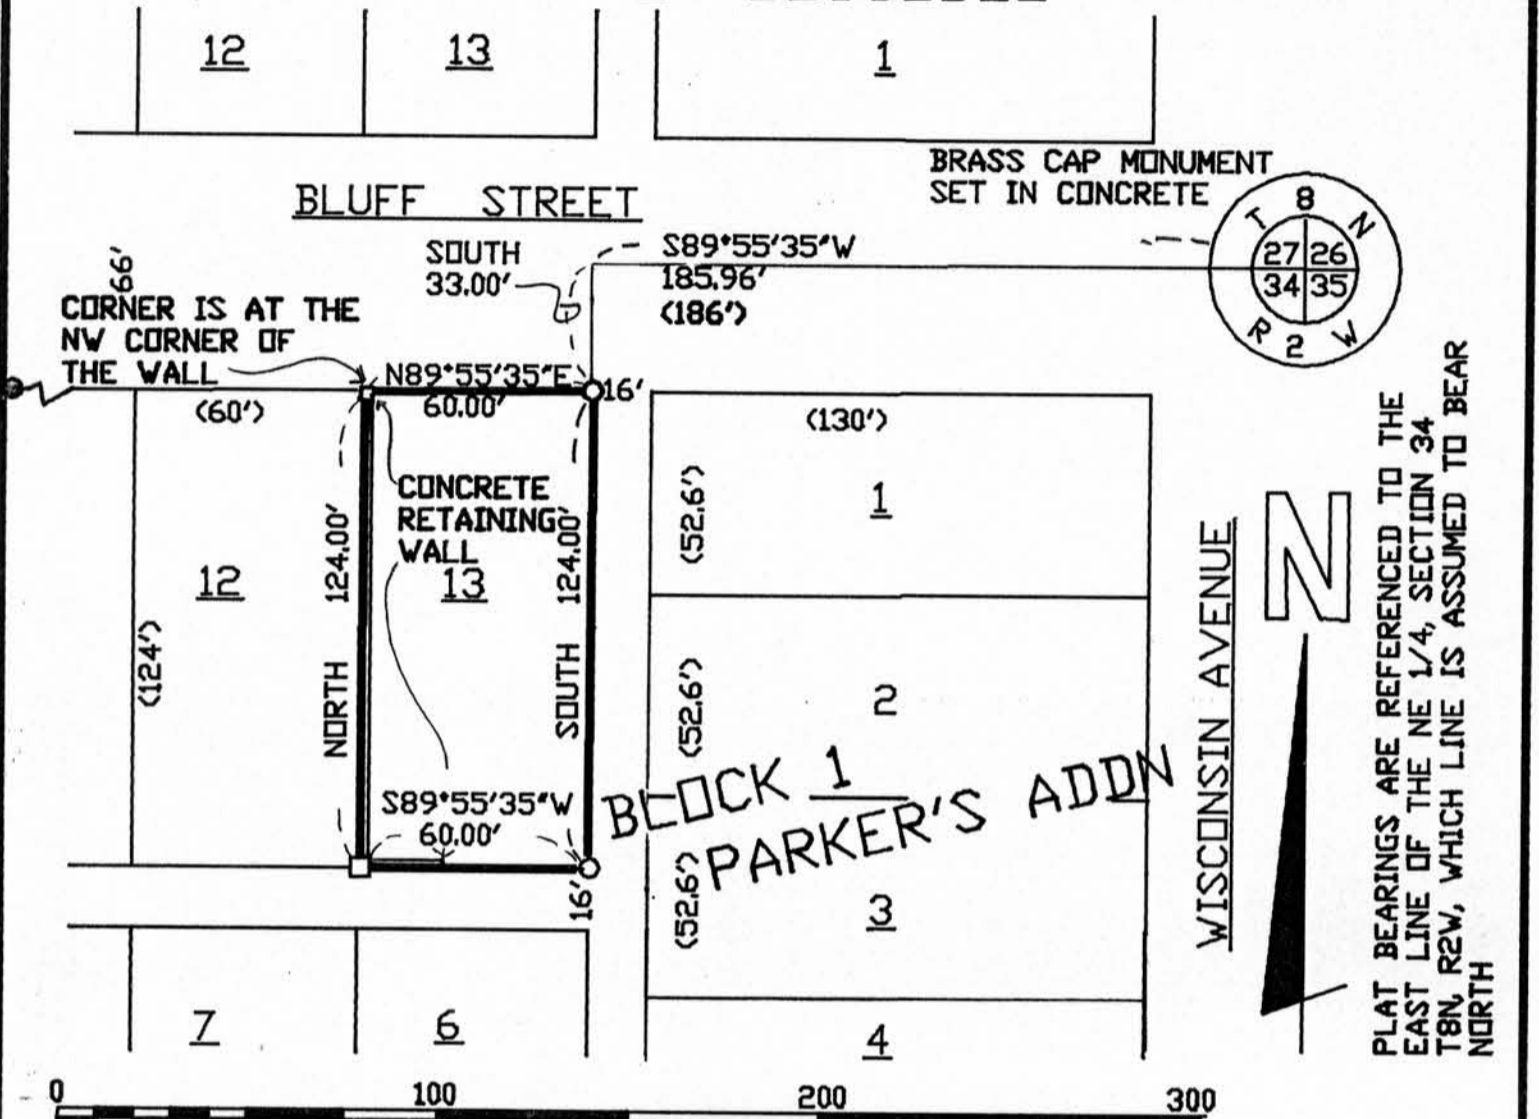

GRAPHIC SCALE - FEET
(ORIG. DWG. 1"=50')

LEGEND:

- FOUND 1" DIA. IRON PIPE
- 1"X24" IRON PIPE SET
- △ 3/4"X24" REBAR SET
- CHISELED VERT. LINE AT SW CORNER OF CONC. WALL
- () RECORDED AS

DESCRIPTION:

LOT 13, BLOCK 1 OF PARKER'S ADDITION TO THE CITY OF BOSCOBEL, BEING IN THE NE 1/4 OF THE NE 1/4 OF SECTION 34, T8N, R2W, GRANT COUNTY, WI.

OFFICE DATA:

JOB ID: 85S-100
SURVEY CREW: BB & KP
FIELD BOOK NO.: SEE FILE
DISK STORED:
IBM DATA DISK: BOWDEN
DRAWN BY: LES
DRAWING NO.: 850 88A

SURVEYOR'S CERTIFICATE

I HEREBY CERTIFY THAT I HAVE MADE A SURVEY ACCORDING TO THE DESCRIPTION FURNISHED ME BY DAVE MICONOWICZ AND THAT THE PLAT DRAWN HEREON IS A CORRECT REPRESENTATION OF THAT SURVEY TO THE BEST OF MY KNOWLEDGE AND BELIEF

Bruce D. Bowden
BRUCE D. BOWDEN S-1250
April 1, 1986
DATE

