


Sec. 16, T4N, R3W

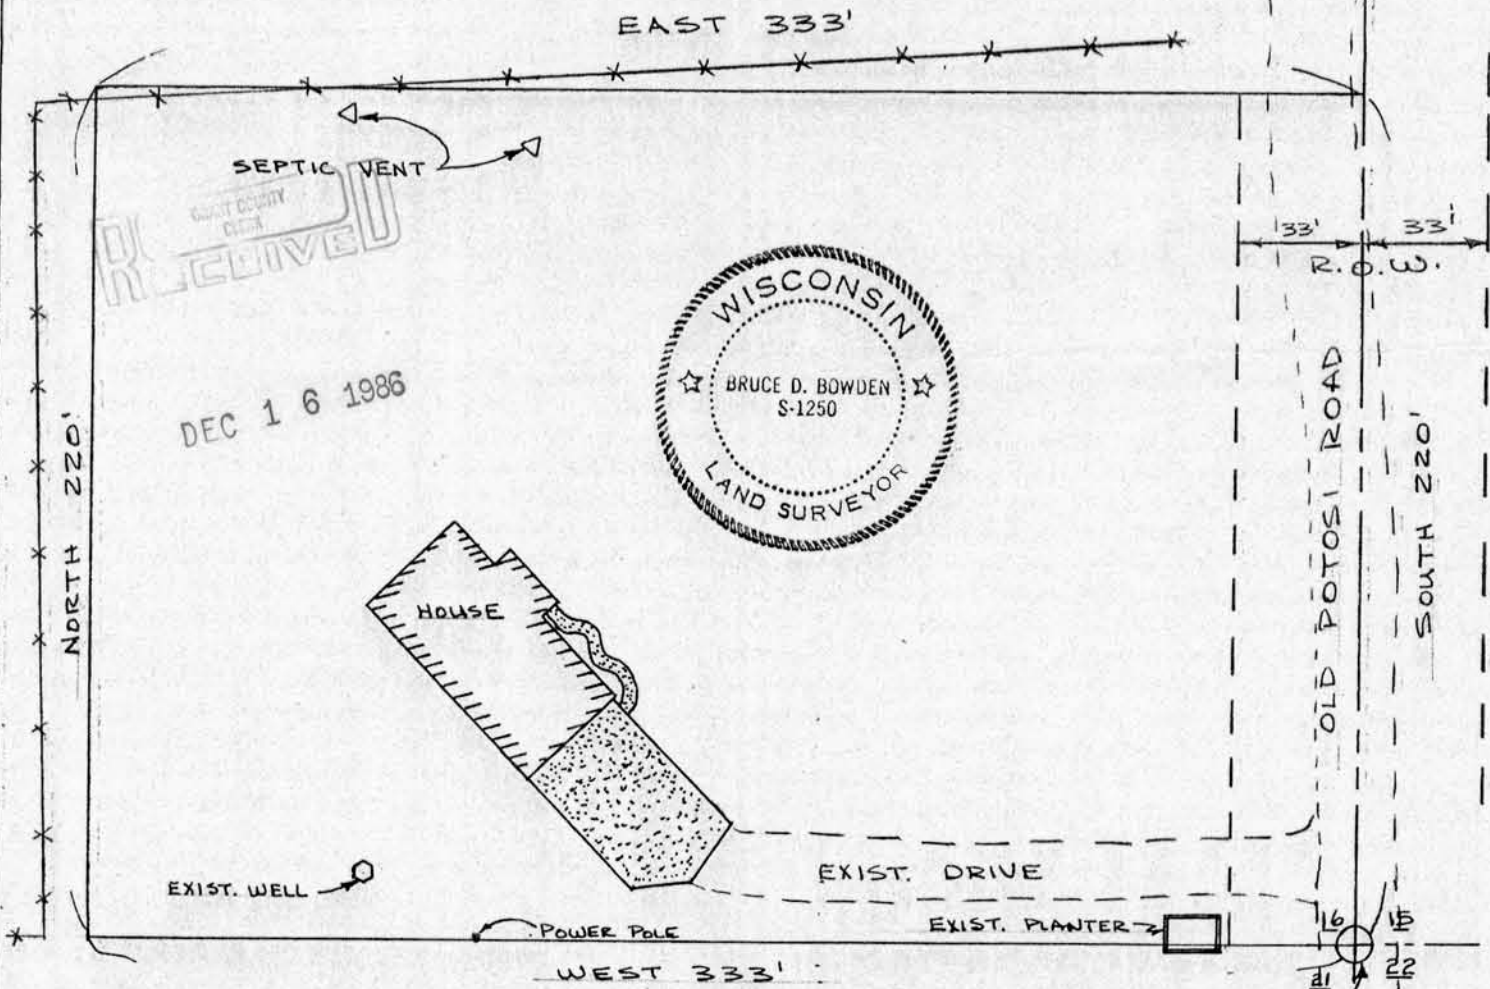

LEGEND
 [Symbol] EXISTING CONC.
 [Symbol] EXISTING FENCE

SE COR SEC. 16,
 T4N, R3W, GRANT CO., WISC

SCALE: 1"=50'

LEGAL DESCRIPTION: COMMENCING AT THE SOUTHEAST CORNER OF S.E. 1/4 OF S.E. 1/4 OF SECTION 16, T 4 N, R 3 W; THENCE WEST 333 FEET; THENCE NORTH 220 FEET; THENCE SOUTH 220 FEET ALONG THE CENTERLINE OF OLD POTOSI ROAD TO THE PLACE OF BEGINNING. SUBJECT TO HIGHWAY ALONG THE EAST SIDE THEREOF AND EXISTING EASEMENTS.

CLIENT'S STATEMENT REGARDING WORK

AS CLIENT(S) OF BRUCE D. BOWDEN, REGISTERED LAND SURVEYOR, I/WE REQUEST THAT THE SURVEY BE MADE ACCORDING TO THE FOLLOWING SPECIFICATIONS:

- 1) ONLY ENOUGH WORK BE PERFORMED TO SATISFY THE REQUIREMENTS OF ANCHOR SAVINGS AND LOAN
- 2) NO MONUMENTATION BE SET TO MARK THE CORNERS OF THE PARCEL.
- 3) THE EXACT LENGTH AND BEARINGS OF THE BOUNDARIES OF THE PARCEL NEED NOT BE SHOWN.
- 4) MEASUREMENTS NEED NOT BE TAKEN AS SPECIFIED IN A-E 5.01(6) OF THE WISCONSIN ADMINISTRATIVE CODE. IT IS SPECIFICALLY INTENDED TO EXEMPT THIS SURVEY FROM THE REQUIREMENTS OF A-E 5.01(5)(c) AND (d) AND A-E 5.01(6) OF THE WISCONSIN ADMINISTRATIVE CODE.

Karen S. Ewald

DATE 5-16-86

SURVEYOR'S CERTIFICATE

I HEREBY CERTIFY THAT I HAVE SURVEYED THE ABOVE DESCRIBED PARCEL AND THAT THE ABOVE MAP IS A TRUE REPRESENTATION THEREOF AND SHOWS THE SIZE AND LOCATION OF THE PARCEL, IT'S RECORDED EXTERIOR BOUNDARIES, THE LOCATION OF VISIBLE ROADWAYS AND ENCROACHMENTS, IF ANY. THIS SURVEY IS MADE FOR THE USE OF THE PRESENT OWNER'S OF THE PROPERTY AND ALSO THOSE WHO PURCHASE, MORTGAGE, OR GUARANTEE THE TITLE THERTO WITHIN ONE YEAR FROM THE DATE HEREOF.

Bruce D. Bowden May 13, 1986
 BRUCE D. BOWDEN #1250 DATE