


MORTGAGE INSPECTION SURVEY

RECEIVED

DEC 16 1986

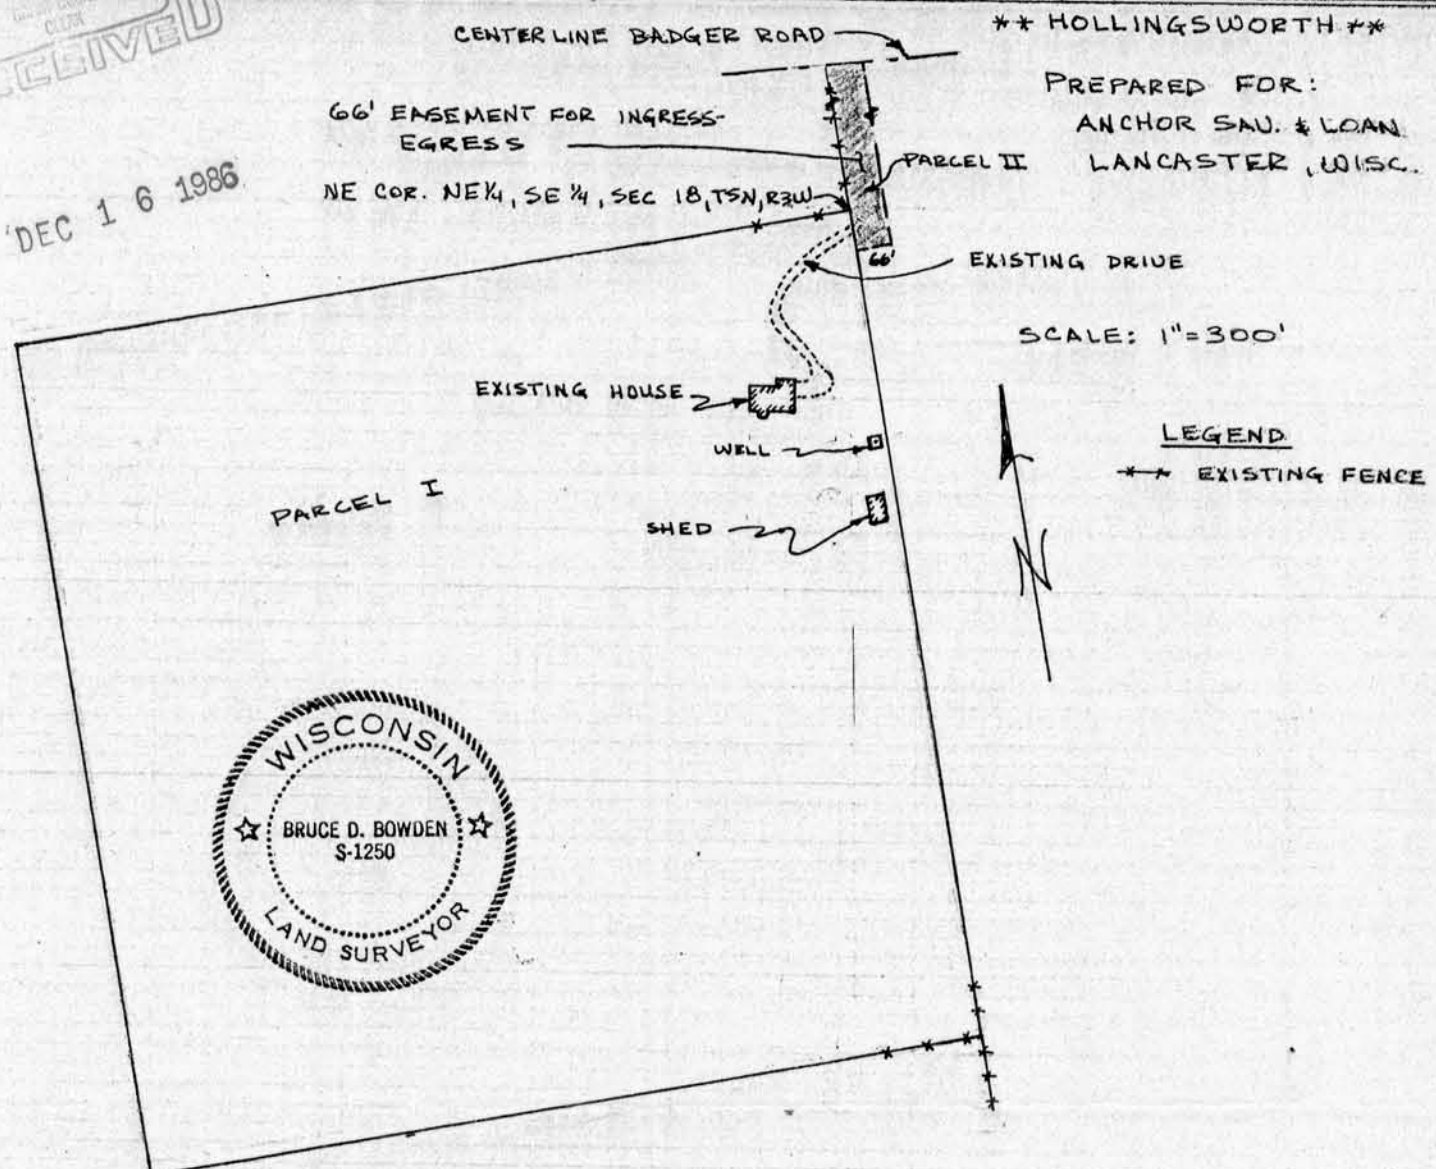

DESCRIPTION: PARCEL I: THE NE $\frac{1}{4}$ OF THE SE $\frac{1}{4}$ OF SECTION 18, T 5 N., R 3 W OF THE 4TH P.M. GRANT COUNTY, WISCONSIN.
 PARCEL II: NON-EXCLUSIVE EASEMENT FOR THE BENEFIT OF PARCEL I FOR INGRESS AND EGRESS OVER UNDER, AND ACROSS THE PREMISES DESCRIBED AS FOLLOWS: COMMENCING AT THE NORTHEAST CORNER OF THE N.E. $\frac{1}{4}$ OF THE S.E. $\frac{1}{4}$ OF SECTION 18; THENCE SOUTH 66 FEET; THENCE EAST 66 FEET; THENCE NORTH TO THE CENTER OF THE TOWN HIGHWAY IN THE N.W. $\frac{1}{4}$ OF SECTION 17; THENCE WEST 66 FEET TO THE SECTION LINE BETWEEN SECTIONS 17 & 18; THENCE SOUTH TO THE POINT OF BEGINNING. ALL IN T 5 N., R 3 W OF THE 4TH P.M., GRANT COUNTY, WISCONSIN.

CLIENT'S STATEMENT REGARDING WORK
 AS CLIENT(S) OF BRUCE D. BOWDEN, REGISTERED LAND SURVEYOR, I/WE REQUEST THAT THE SURVEY BE MADE ACCORDING TO THE FOLLOWING SPECIFICATIONS:

- 1) ONLY ENOUGH WORK BE PERFORMED TO SATISFY THE REQUIREMENTS OF ANCHOR SAVINGS AND LOAN
- 2) NO MONUMENTATION BE SET TO MARK THE CORNERS OF THE PARCEL.
- 3) THE EXACT LENGTH AND BEARINGS OF THE BOUNDARIES OF THE PARCEL NEED NOT BE SHOWN.
- 4) MEASUREMENTS NEED NOT BE TAKEN AS SPECIFIED IN A-E 5.01(6) OF THE WISCONSIN ADMINISTRATIVE CODE. IT IS SPECIFICALLY INTENDED TO EXEMPT THIS SURVEY FROM THE REQUIREMENTS OF A-E 5.01(5)(c) AND (d) AND A-E 5.01(6) OF THE WISCONSIN ADMINISTRATIVE CODE.

James J. Euland DATE 5/16/86

SURVEYOR'S CERTIFICATE
 I HEREBY CERTIFY THAT I HAVE SURVEYED THE ABOVE DESCRIBED PARCEL AND THAT THE ABOVE MAP IS A TRUE REPRESENTATION THEREOF AND SHOWS THE SIZE AND LOCATION OF THE PARCEL, IT'S RECORDED EXTERIOR BOUNDARIES, THE LOCATION OF VISIBLE ROADWAYS AND ENCROACHMENTS, IF ANY. THIS SURVEY IS MADE FOR THE USE OF THE PRESENT OWNERS OF THE PROPERTY AND ALSO THOSE WHO PURCHASE, MORTGAGE, OR GUARANTEE THE TITLE THERETO WITHIN ONE YEAR FROM THE DATE HEREOF.

Bruce D. Bowden May 15, 1986
 BRUCE D. BOWDEN RLS # 1250 DATE