

**BENCHMARK SURVEYS, INC.**  
P. O. BOX 486 608-583-2333  
RICHLAND CENTER, WISCONSIN 53581



SURVEYING - PLANNING



SCALE 1" = 300'

LOCATION REPORT  
**PLAT OF SURVEY**


FOR

HAROLD KRUBSACK

AGENT: Anchor Savings and Loan

FURNISHED DESCRIPTION:

All that portion of the Northwest  $\frac{1}{4}$  of the Southeast  $\frac{1}{4}$  of Section 26, Town 7 North, Range 3 West, Lying South and East of the Town road known as Stenner Hill Road as it appears in October of 1986 all in Grant County, Wisconsin.

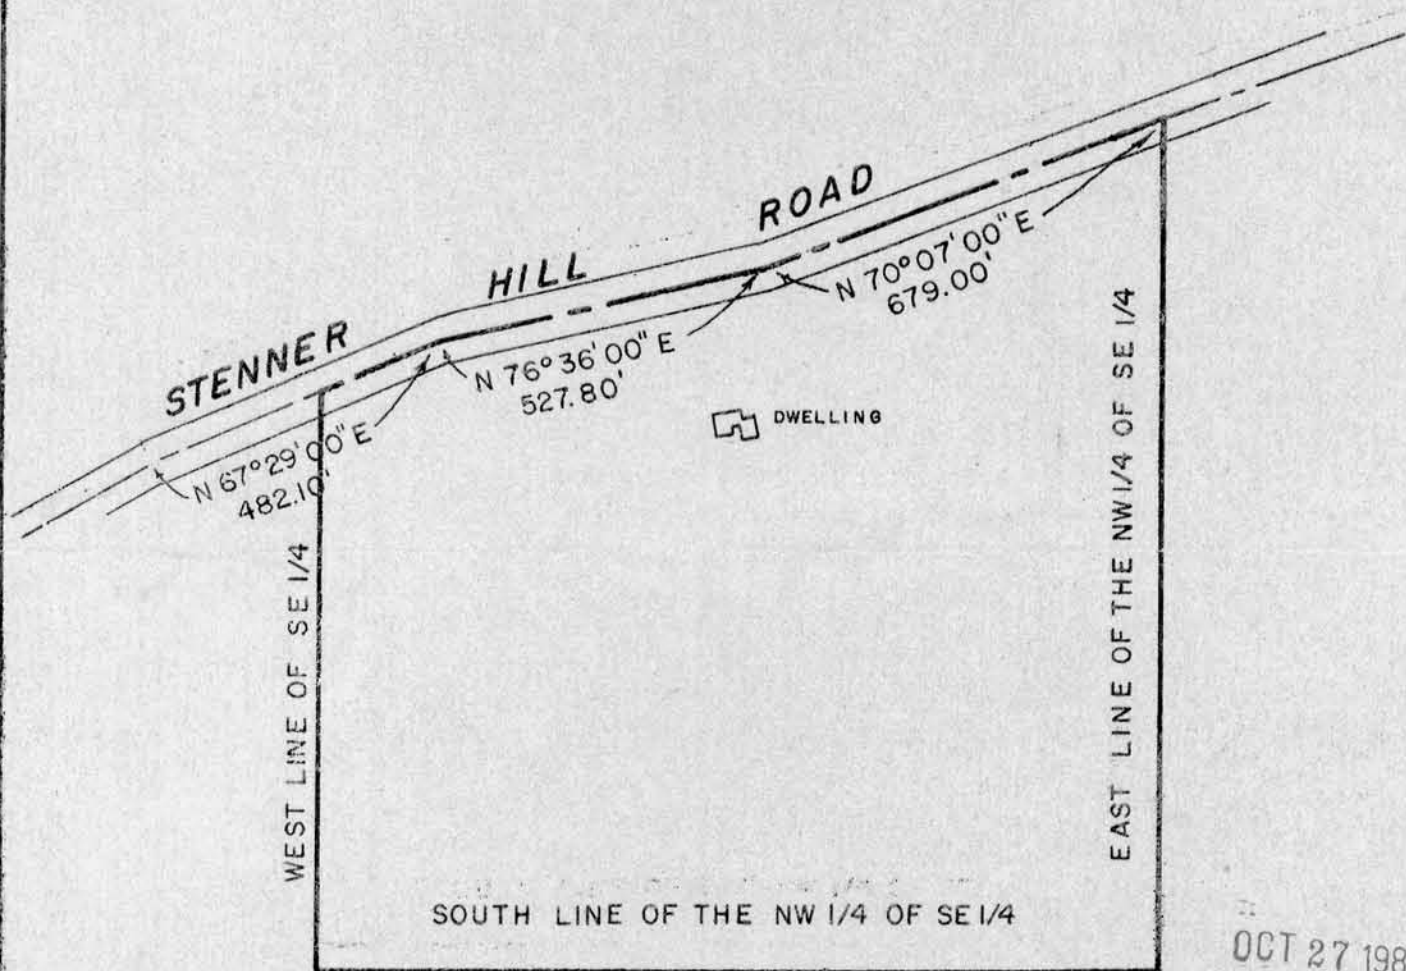

OCT 27 1986

RECEIVED

WAIVER:

We hereby acknowledge that all standards set forth in the Wisconsin Administrative Code Chapter A-E 5.01 for minimum surveying standards are being waived.

Owner/Agent	Date	Owner/Agent	Date
-------------	------	-------------	------

" I HAVE SURVEYED THE ABOVE DESCRIBED PROPERTY, AND THE ABOVE MAP IS A TRUE REPRESENTATION THEREOF AND SHOWS THE SIZE AND LOCATION OF THE PROPERTY, ITS EXTERIOR BOUNDARIES, THE LOCATION AND DIMENSIONS OF ALL STRUCTURES THEREON, FENCES, ROADWAYS, APPARENT EASEMENTS AND ENCROACHMENTS, IF ANY.

THIS SURVEY IS MADE FOR THE EXCLUSIVE USE OF THE PRESENT OWNERS OF THE PROPERTY, AND ALSO THOSE WHO PURCHASE, MORTGAGE OR GUARANTEE THE TITLE THEREOF, WITHIN ONE (1) YEAR FROM DATE HEREOF; AND AS TO THEM I HEREBY CERTIFY THAT SAID SURVEY AND THE ABOVE MAP WERE MADE IN ACCORDANCE WITH ACCEPTABLE PROFESSIONAL STANDARDS AND THAT THE INFORMATION CONTAINED HEREON IS, TO THE BEST OF MY KNOWLEDGE, INFORMATION AND BELIEF A TRUE AND ACCURATE REPRESENTATION THEREOF.

DATED OCTOBER 16, 1986 *[Signature]*

