
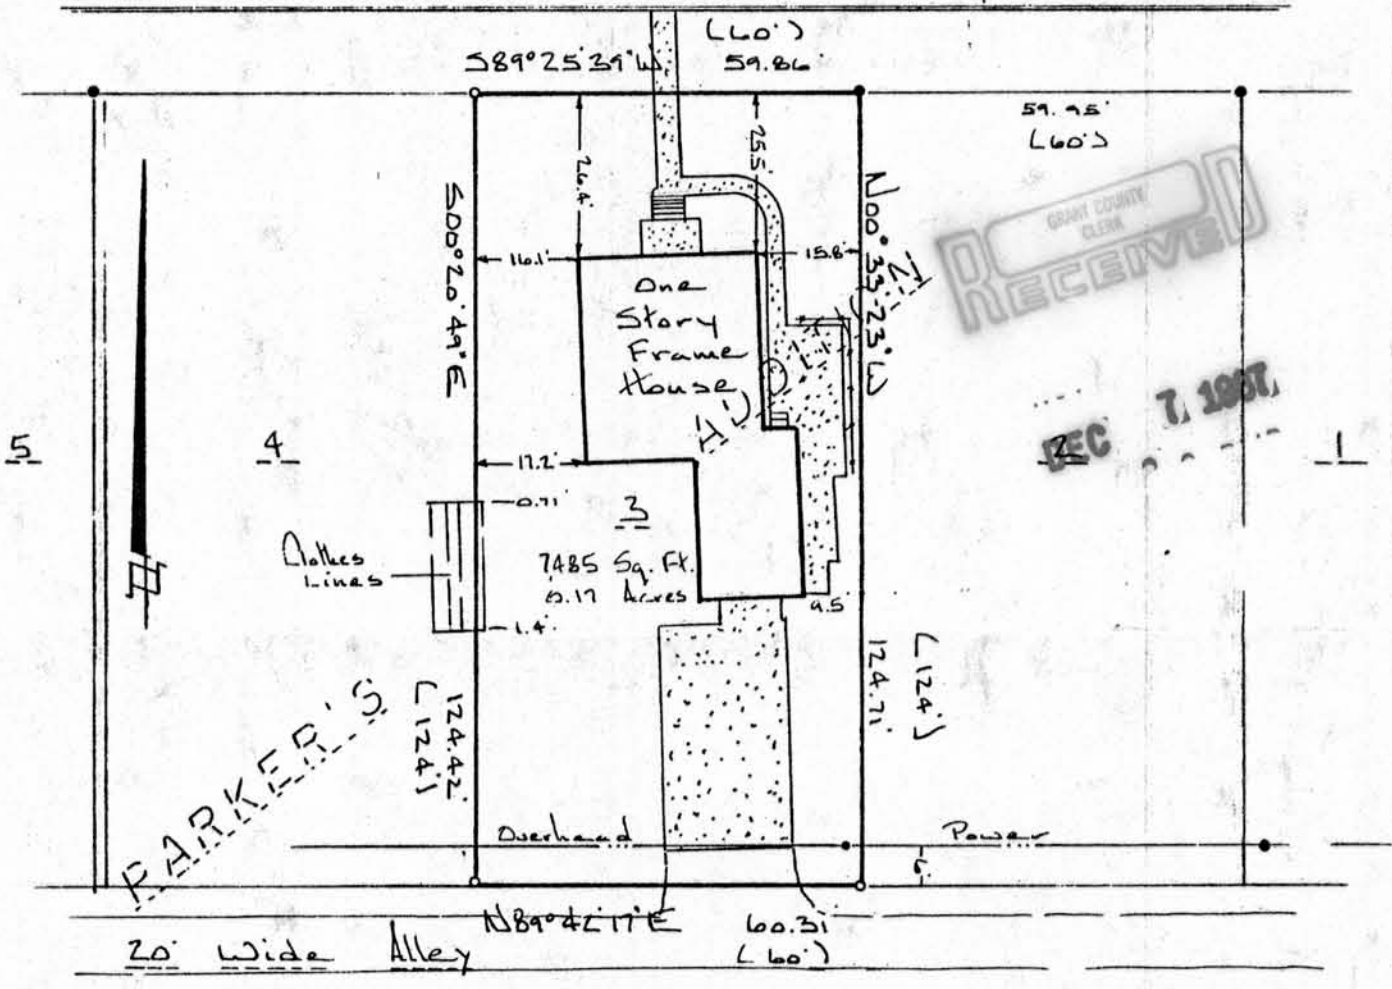


PLAT OF SURVEY

Lot Three (3) of Block Three (3) of Parker's Addition To The Village (Now City) of Boscobel, Grant County Wisconsin. According To The Recorded Map Or Plat Thereof. Being A Part Of The NE 1/4 Of The NE 1/4 Of Section 34. T8N. R3W.

Original Block 43 Plat

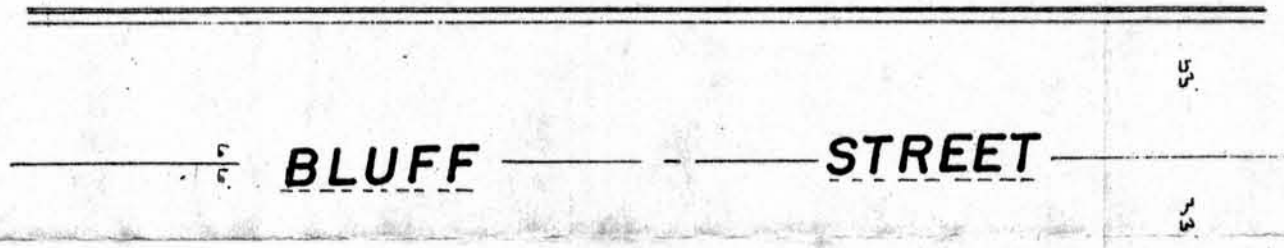

Prepared for:
Arnold and Lucetia Harris
Bluff Street
Boscobel, WI

Prepared By:
River Valley Land Surveying
1502 Lori Court
Sauk City, WI

- Denotes 3/4" X 24" solid round iron rod set
- Denotes 1-1/4" iron pipe found
- "Recorded as" distances are shown in parentheses
- Bearings are referenced to City of Boscobel survey datum.

SURVEYOR'S CERTIFICATE
I have surveyed the above described property and the map shown hereon is a true representation thereof and shows the size and location of the property and its exterior boundaries. This survey was prepared under the direction of Arnold Harris and has been performed in full compliance with the provisions of Section A.E. 5.01 of the Wisconsin Administrative Code.
Dated this 16th day of November, 1987

Richard Marks
Richard Marks

S-1473

