


34

MORTGAGE SURVEY

Sec 5, T2N, R1W



DEC 2

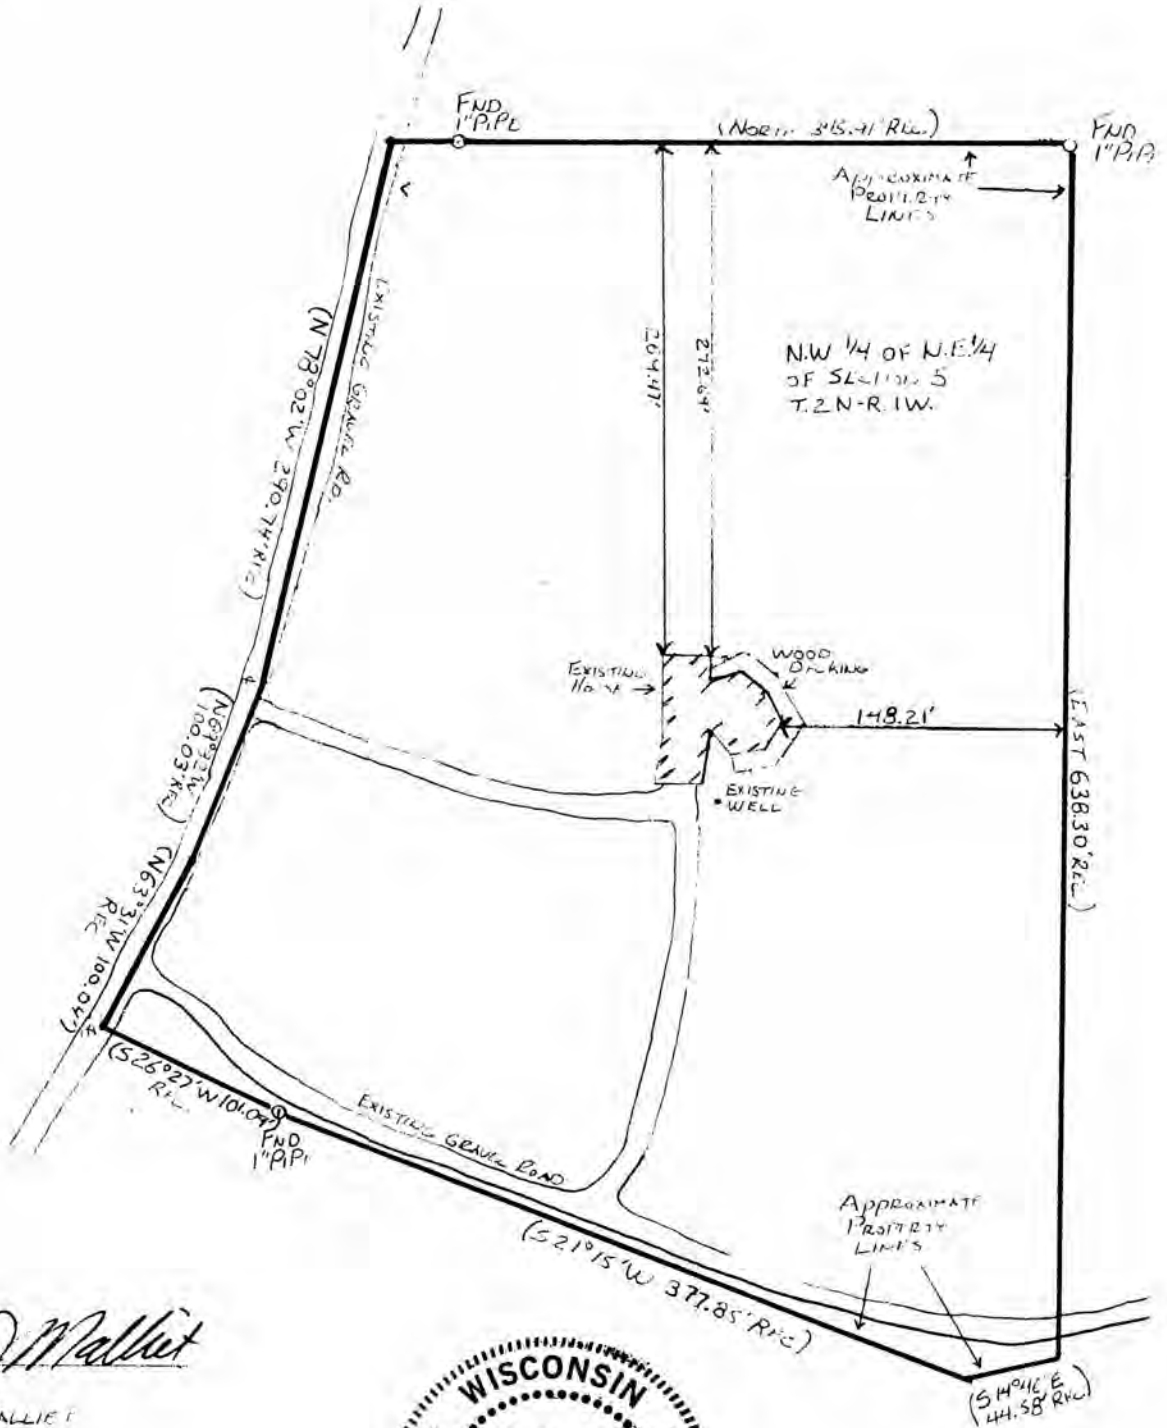

Douglas J. Malliet

DOUGLAS J. MALLIET
S-1266
REGISTERED LAND SURVEYOR
OCTOBER 13, 1988



D. F. BURBACH MUNICIPAL & CIVIL ENGINEERS

5992 STATE HIGHWAY 80 SOUTH • PLATTEVILLE, WISCONSIN 53818 • (608) 348-3262