

# MORTGAGE SURVEY


65

Sec 15, T3N R1W

THIRD STREET (ASPHALT)

GRANT COUNTY CLERK RECEIVED

DEC 21 1990

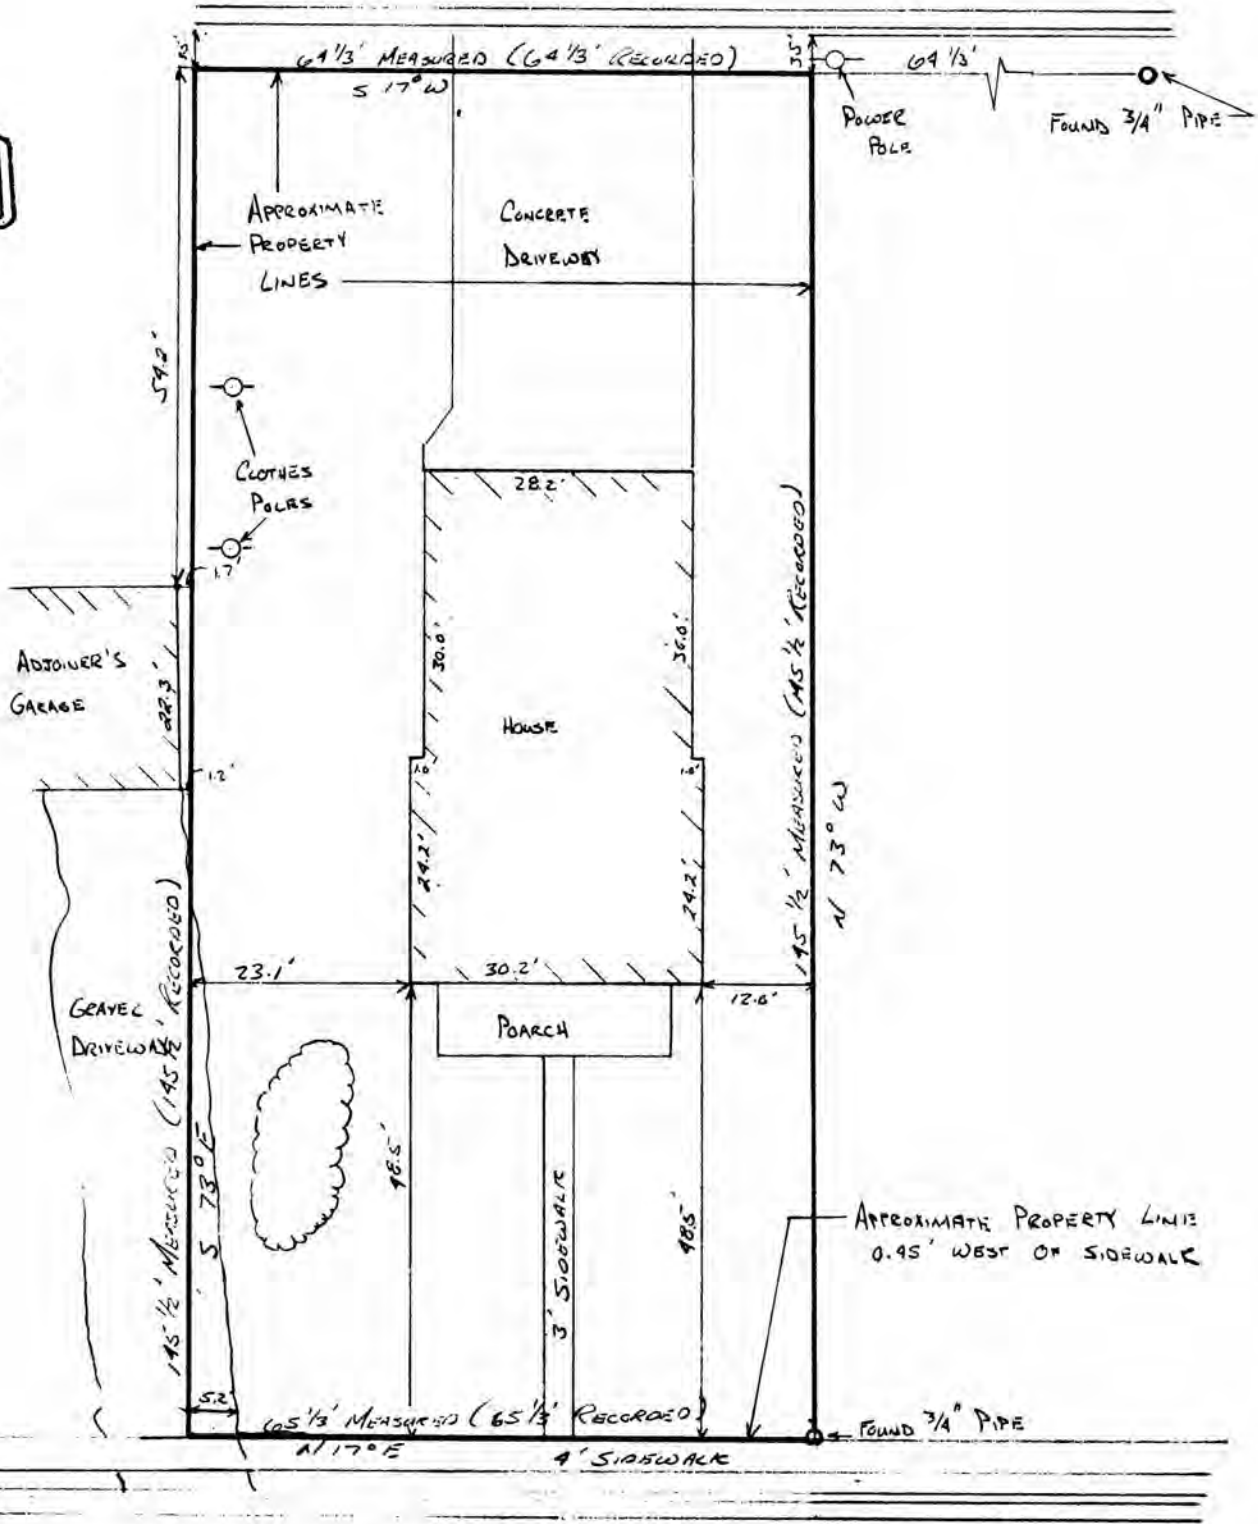

SECOND STREET (ASPHALT)

*Douglas J. Malliet*  
 DOUGLAS J. MALLIET  
 S-1266  
 REGISTERED LAND SURVEYOR  
 OCTOBER 10<sup>th</sup> 1988



**D. F. BURBACH MUNICIPAL & CIVIL ENGINEERS**

5992 STATE HIGHWAY 80 SOUTH • PLATTEVILLE, WISCONSIN 53818 • (608) 348-3262

LEGAL DESCRIPTION:

Begin at the center of a stone monument imbedded in the ground which marks the 1/16 Section corner between the North East Quarter (N.E. 1/4) and the North West Quarter (N.W. 1/4) of Section Fifteen (15) in Town Three (3) North Range One (1) West of the 4th P.M. and in the City of Platteville, Grant County, Wisconsin, thence run North 476 links, thence run S. 73 degrees E. 22 links to Second Street, thence run N. 17 degrees E. along the West boundary line of Second Street 62 feet to an iron stake driven in the ground and to the South East corner of the lot to be described and the place where this survey begins; thence N. 17 degrees E. along the West boundary line of Second Street 65 1/3 feet to an iron stake driven in the ground, thence N. 73 degrees W. 145 1/2 feet to an iron stake driven in the ground and to Third Street, thence S. 17 degrees W. along the East boundary line of Third Street 64 1/3 feet to an iron stake driven in the ground, thence S. 73 degrees E. 145 1/2 feet to the place of beginning.

SURVEYOR'S NOTE:

As clients of D. F. Burbach Municipal & Civil Engineers, I/we request that the inspection be made according to the following specifications:

- 1). Only enough work be performed to satisfy the requirements of the lending institution.
- 2). Only recorded (Deed) distances and bearings be shown.

It is specifically intended to exempt this inspection from the requirements of A-E 7.03, A-E 7.05(2), (3), and (4) and A-E 7.06 of the Wisconsin Administrative Code, and is so stated and agreed to as required by A-E 7.01(2).

*Karen J. Lynch*

Dated October 10, 1988

CERTIFICATE: I hereby certify that I have inspected the above described parcel and that the above map is a true representation thereof and shows the approximate location of the parcel, its recorded exterior boundaries, the location of all visible roadways and encroachments, if any. This inspection is made for the use of the purchasers' mortgage institution and is valid for one-half year from the date hereof. I further certify that such inspection and the representation thereof hereon are true and correct to the best of my knowledge and belief.



*Douglas J. Malliet*  
Douglas J. Malliet  
S-1266  
Registered Land Surveyor  
October 10, 1988

**D. F. BURBACH MUNICIPAL & CIVIL ENGINEERS**