

MORTGAGE SURVEY


76

Sec 12 T1N R2W



SCALE 1" = 30'

BRK...
-T-

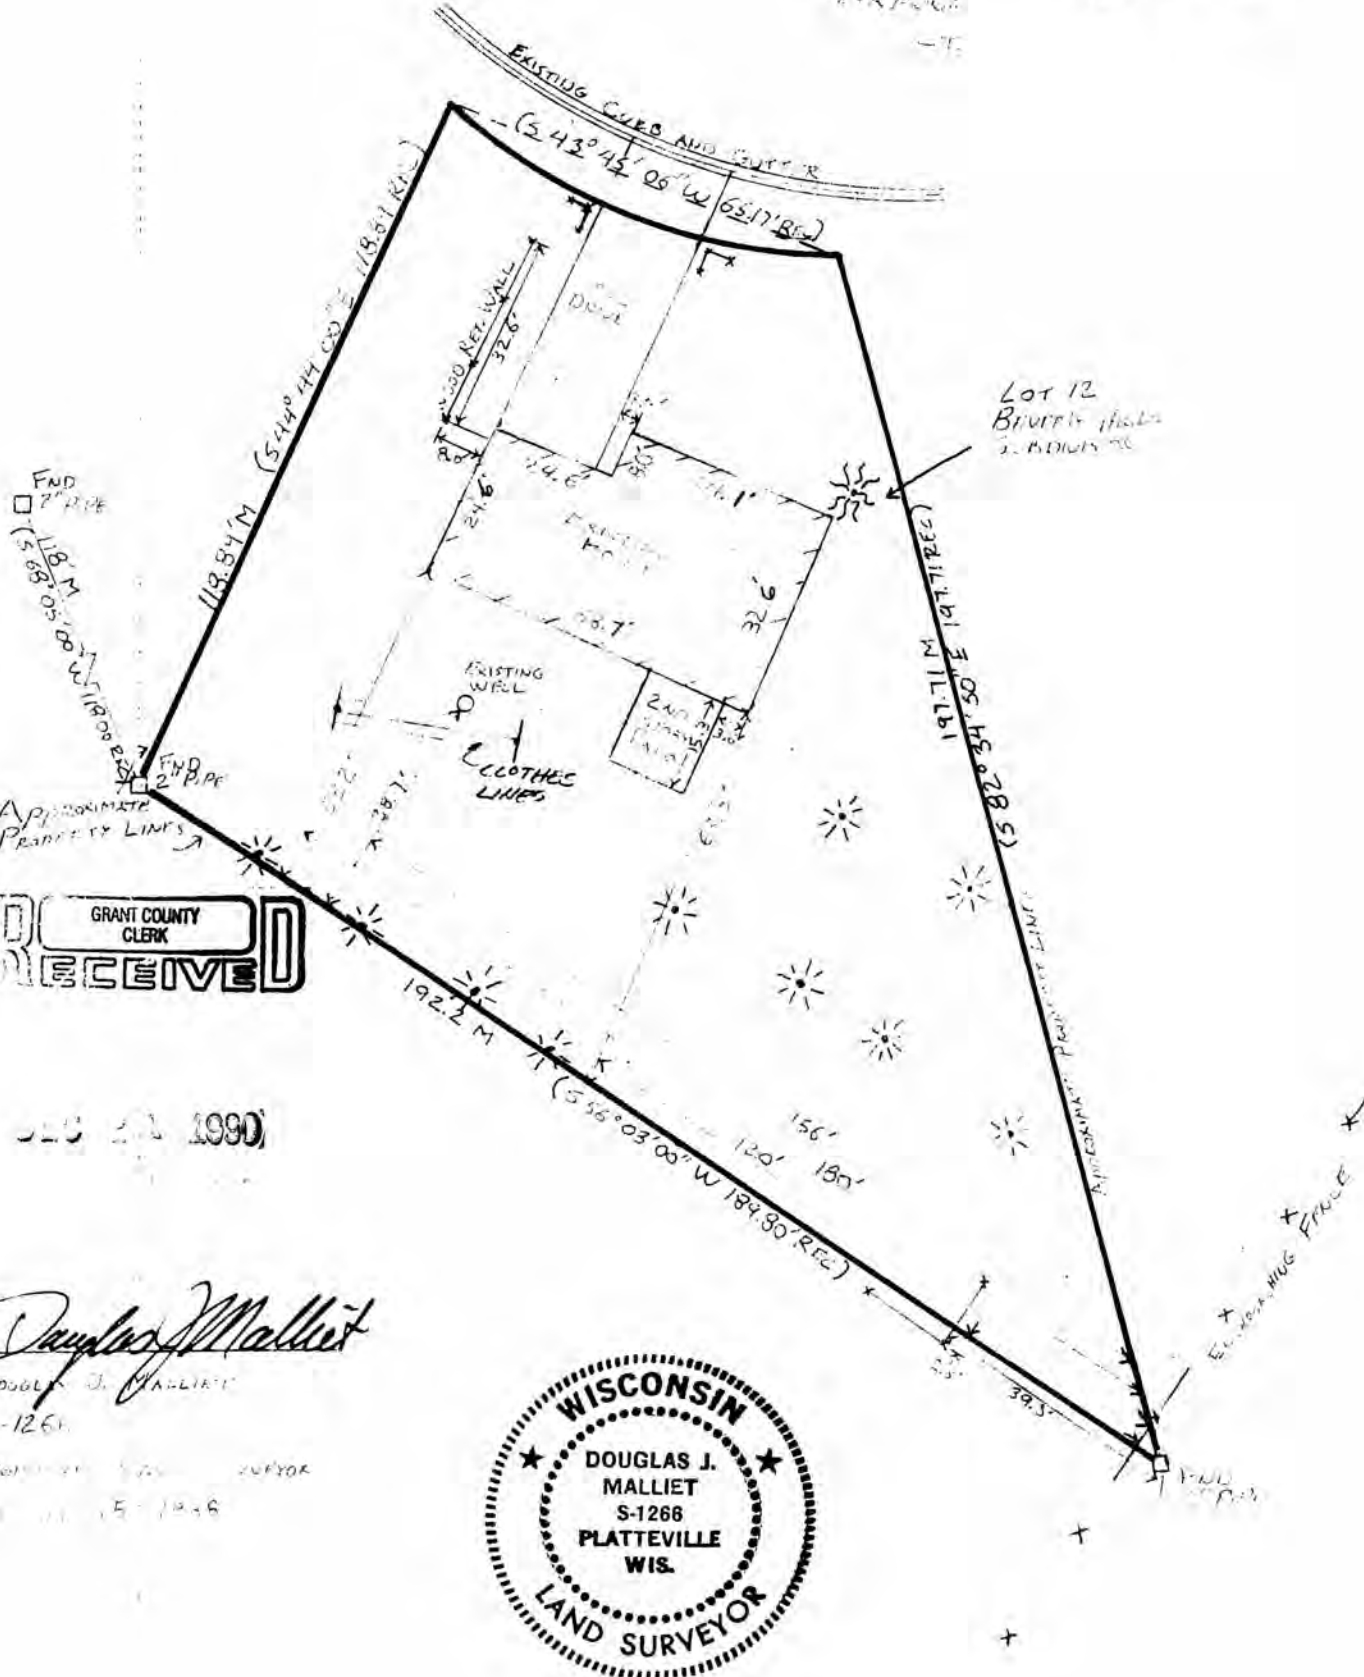

Lot 12
BIRCHFIELD
2. B. DAVIS

FIND
1.8" M
5.89' 05" 00' W 118.61 REC
FIND
2" PIPE
APPROXIMATE
PROPERTY LINES

GRANT COUNTY
CLERK
RECEIVED

JUN 21 1990

Douglas J. Malliet
DOUGLAS J. MALLIET
S-1268
PLATTEVILLE, WISCONSIN



D. F. BURBACH MUNICIPAL & CIVIL ENGINEERS

5992 STATE HIGHWAY 80 SOUTH • PLATTEVILLE, WISCONSIN 53818 • (608) 348-3262