

GRANT COUNTY  
CLERK

111

DEC 21 1988

# SURVEY PLAT

Village of Livingston

*Douglas J. Malliet*


Douglas J. Malliet  
S-1266  
Registered Land Surveyor  
January 5, 1988



### LEGEND

- Set 2" Iron Pipe
- Found 2" Iron Pipe

Surveyed For:  
Village of Livingston  
Livingston, Wisconsin

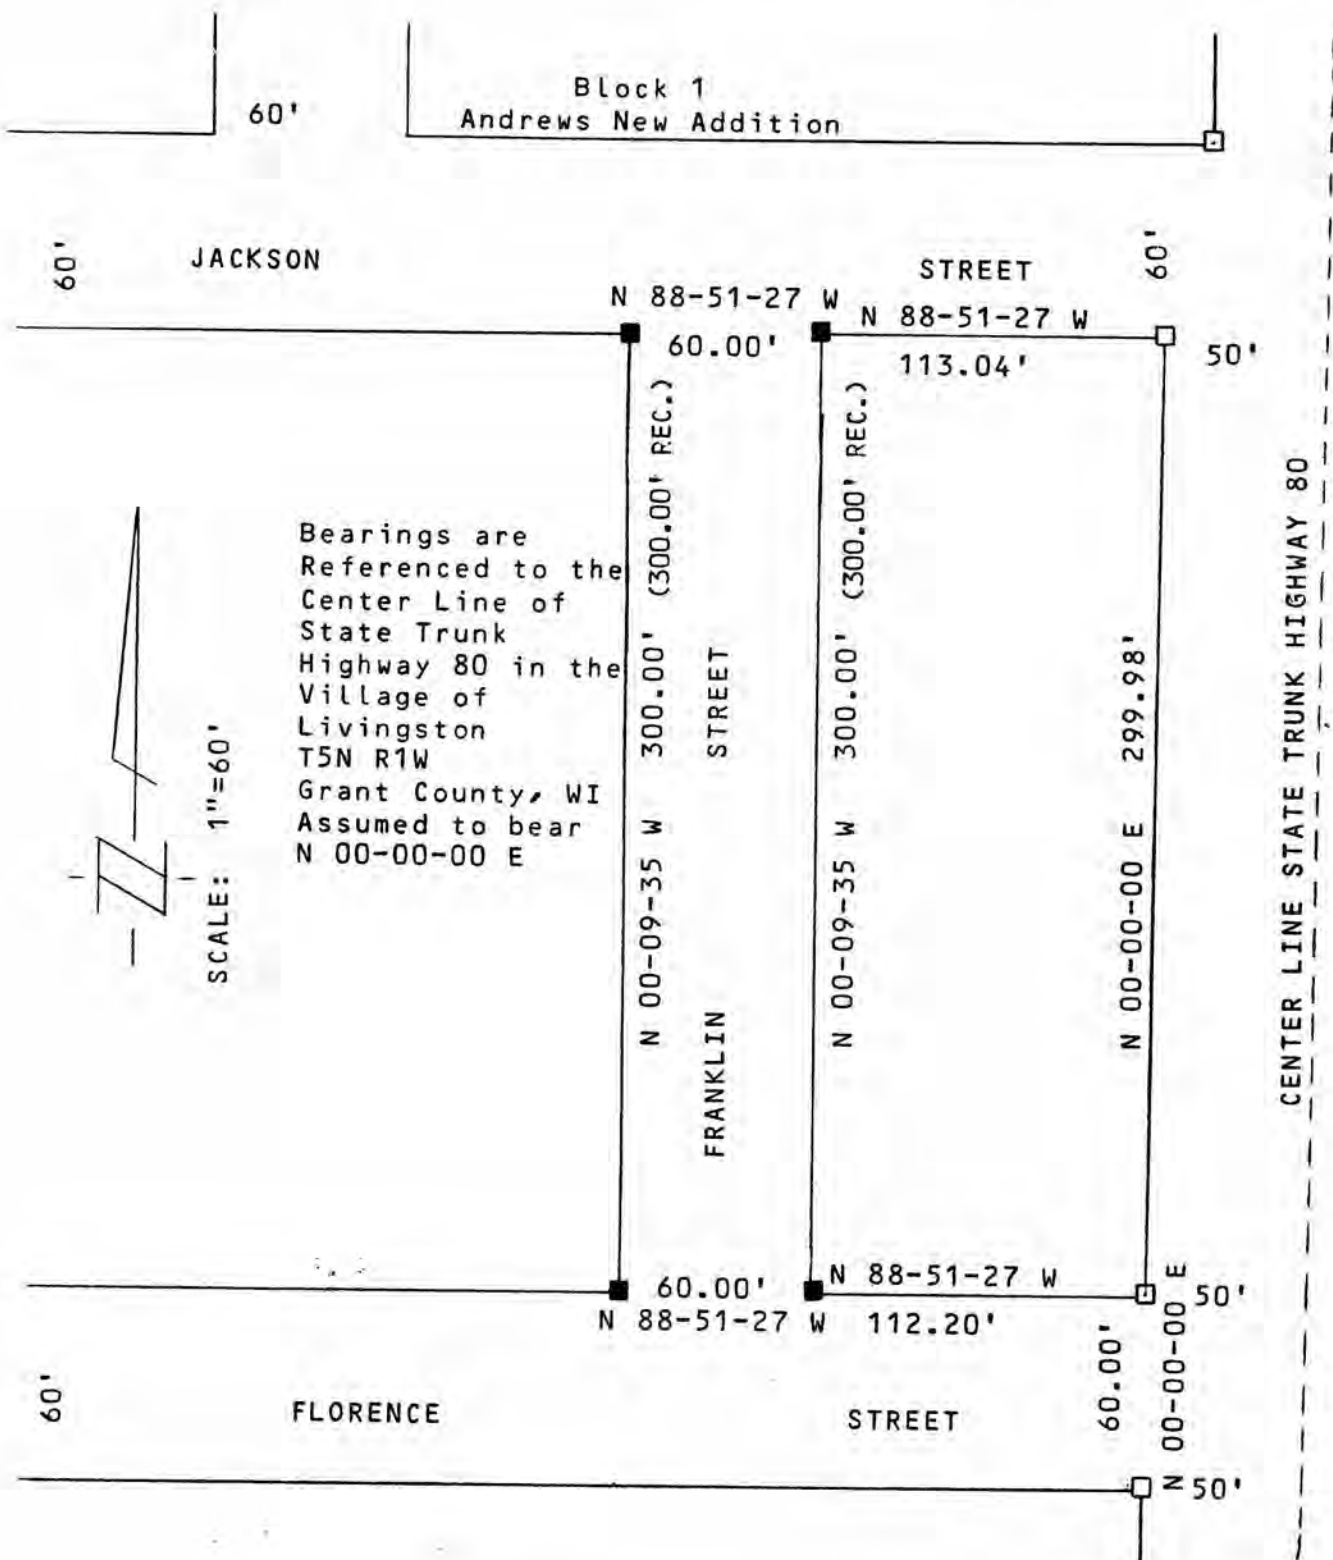

**D. F. BURBACH MUNICIPAL & CIVIL ENGINEERS**

Box 96B, HIGHWAY 80 SOUTH • PLATTEVILLE, WISCONSIN 53818 • (608) 348-3262