


MORTGAGE SURVEY 115

GRANT COUNTY
CLERK
RECEIVED

City of Cuba City -



DEC 24 1989

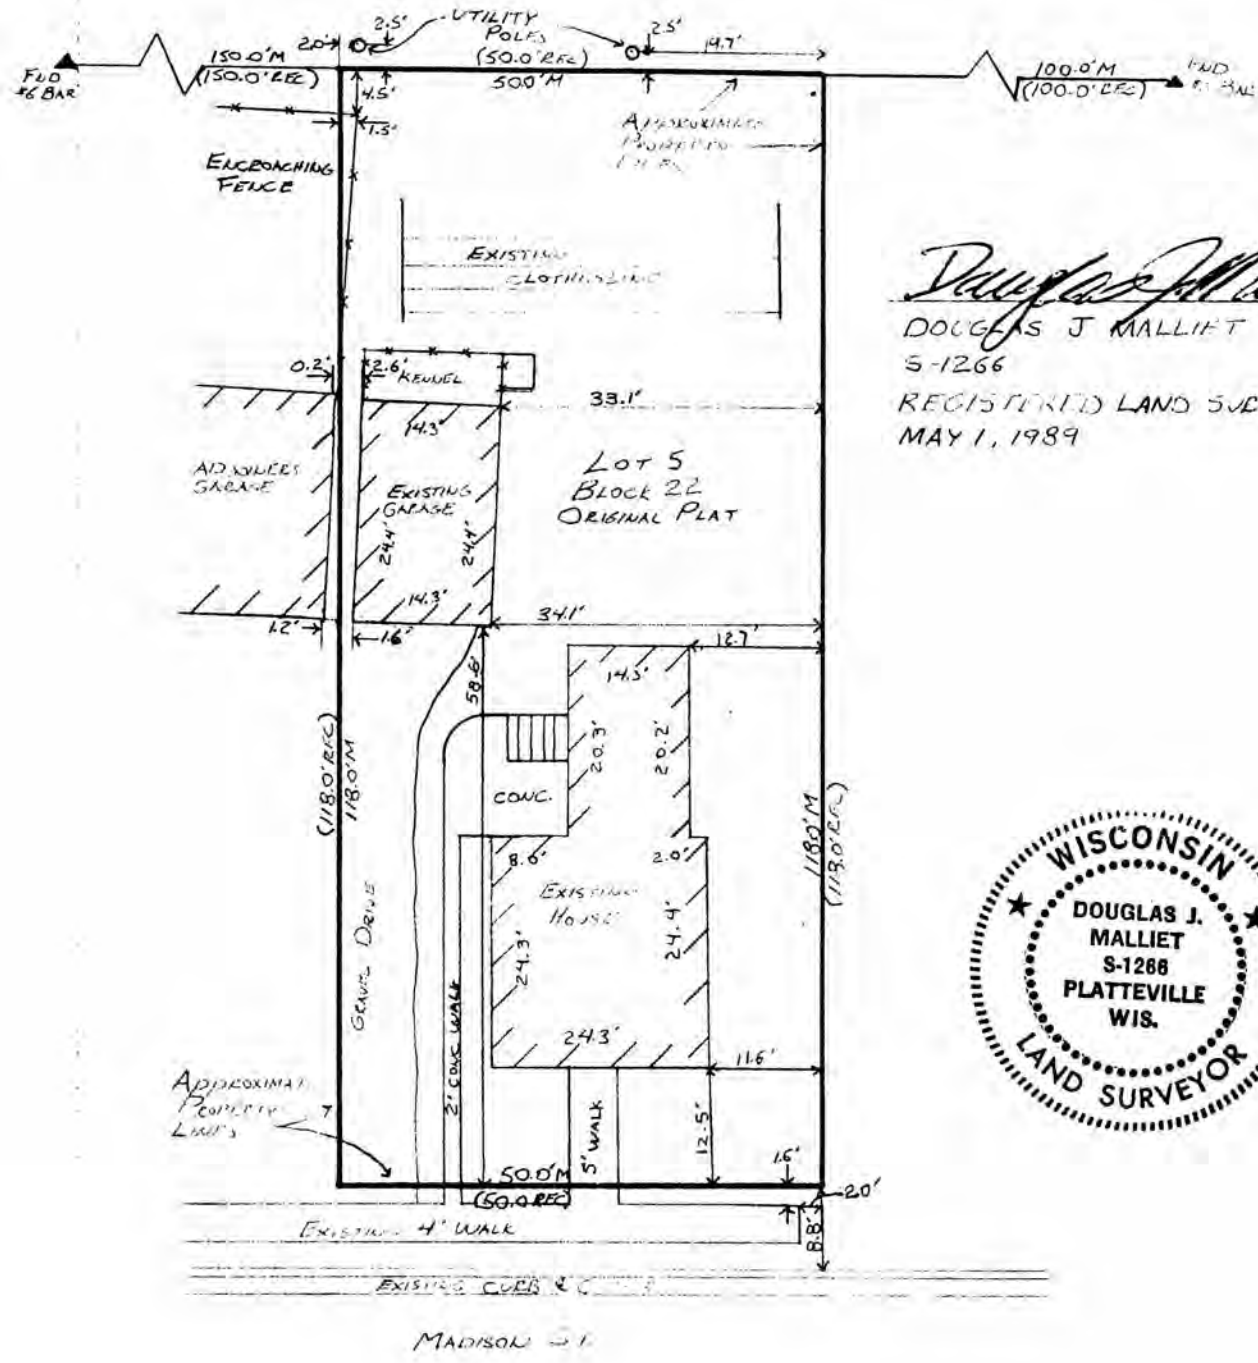

Douglas J. Malliet
DOUGLAS J. MALLIET
S-1266
REGISTERED LAND SURVEYOR
MAY 1, 1989



211

LEGAL DESCRIPTION:

Lot Five (5) in Block Twenty-two (22) of the Original Plat of the Village (now City) of Cuba City, Grant County, Wisconsin, according to the recorded plat thereof, since July 6, 1875 at 3 p.m.

SURVEYOR'S NOTE:

As clients of D. F. Burbach Municipal & Civil Engineers, I/we request that the inspection be made according to the following specifications:

- 1). Only enough work be performed to satisfy the requirements of the lending institution.
- 2). Only recorded (Deed) distances and bearings be shown.

It is specifically intended to exempt this inspection from the requirements of A-E 7.03, A-E 7.05(2), (3), and (4) and A-E 7.06 of the Wisconsin Administrative Code, and is so stated and agreed to as required by A-E 7.01(2).

----- *Karen J. Lynch* -----

Dated May 1, 1989

CERTIFICATE: I hereby certify that I have inspected the above described parcel and that the above map is a true representation thereof and shows the approximate location of the parcel, its recorded exterior boundaries, the location of all visible roadways and encroachments, if any. This inspection is made for the use of the purchasers' mortgage institution and is valid for one-half year from the date hereof. I further certify that such inspection and the representation thereof hereon are true and correct to the best of my knowledge and belief.

Douglas J. Malliet

 Douglas J. Malliet
 S-1268
 Registered Land Surveyor
 May 1, 1989

