

DEC 21

MORTGAGE SURVEY 116

City of Cuba City

Douglas J. Malliet

DOUGLAS J. MALLIET


S-1266

REGISTERED LAND SURVEYOR

SEPTEMBER 21st 1998



ALLEY

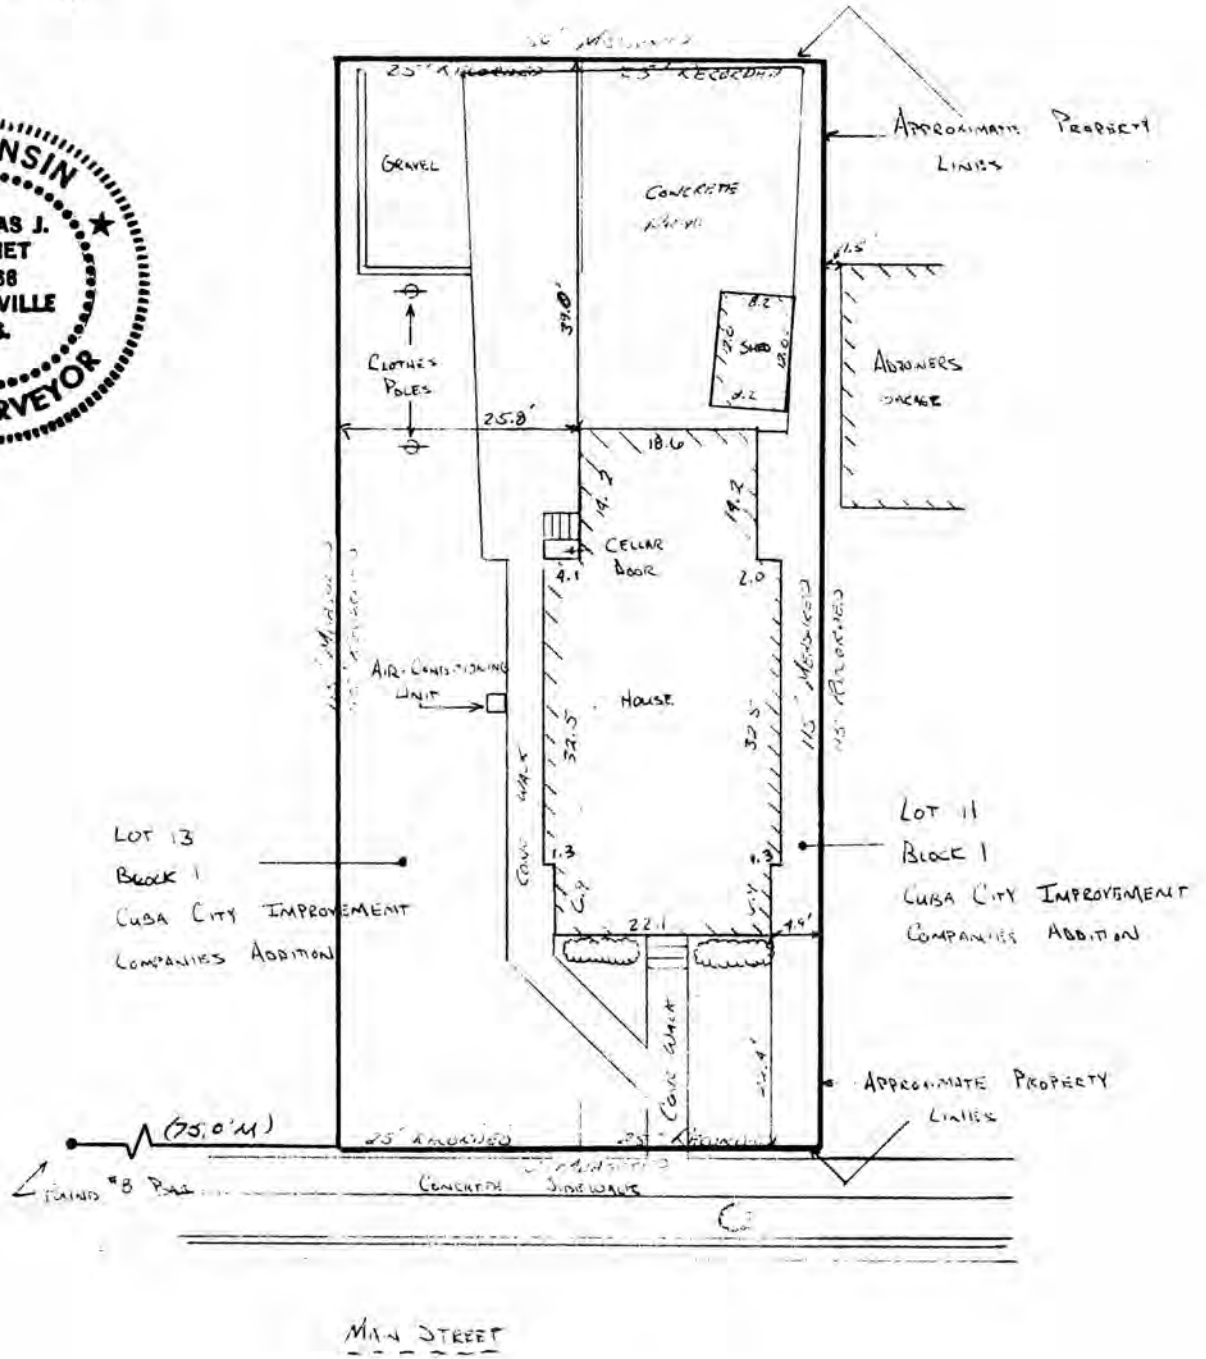

LEGAL DESCRIPTION:

Lots 11 and 13, Block 1, Cuba City Improvement Company's Addition to the Village, now City, of Cuba City, Grant County, Wisconsin.

SURVEYOR'S NOTE:

As clients of D. F. Burbach Municipal & Civil Engineers, I/we request that the inspection be made according to the following specifications:

- 1). Only enough work be performed to satisfy the requirements of the lending institution.
- 2). Only recorded (Deed) distances and bearings be shown.

It is specifically intended to exempt this inspection from the requirements of A-E 7.03, A-E 7.05(2), (3), and (4) and A-E 7.06 of the Wisconsin Administrative Code, and is so stated and agreed to as required by A-E 7.01(2).

L. J. Malliet

Dated September 21, 1988

CERTIFICATE: I hereby certify that I have inspected the above described parcel and that the above map is a true representation thereof and shows the approximate location of the parcel, its recorded exterior boundaries, the location of all visible roadways and encroachments, if any. This inspection is made for the use of the purchasers' mortgage institution and is valid for one-half year from the date hereof. I further certify that such inspection and the representation thereof hereon are true and correct to the best of my knowledge and belief.



Douglas J. Malliet

Douglas J. Malliet
S-1266
Registered Land Surveyor
September 21, 1988