

RECEIVED

DEC 21 1900


MORTGAGE SURVEY 120

City of Cuba City - Clemens Addition



Douglas J. Malliet
DOUGLAS J. MALLIET
5-1264
REGISTERED LAND SURVEYOR
SEPTEMBER 29-1987

SCALE: 1"=20'
N

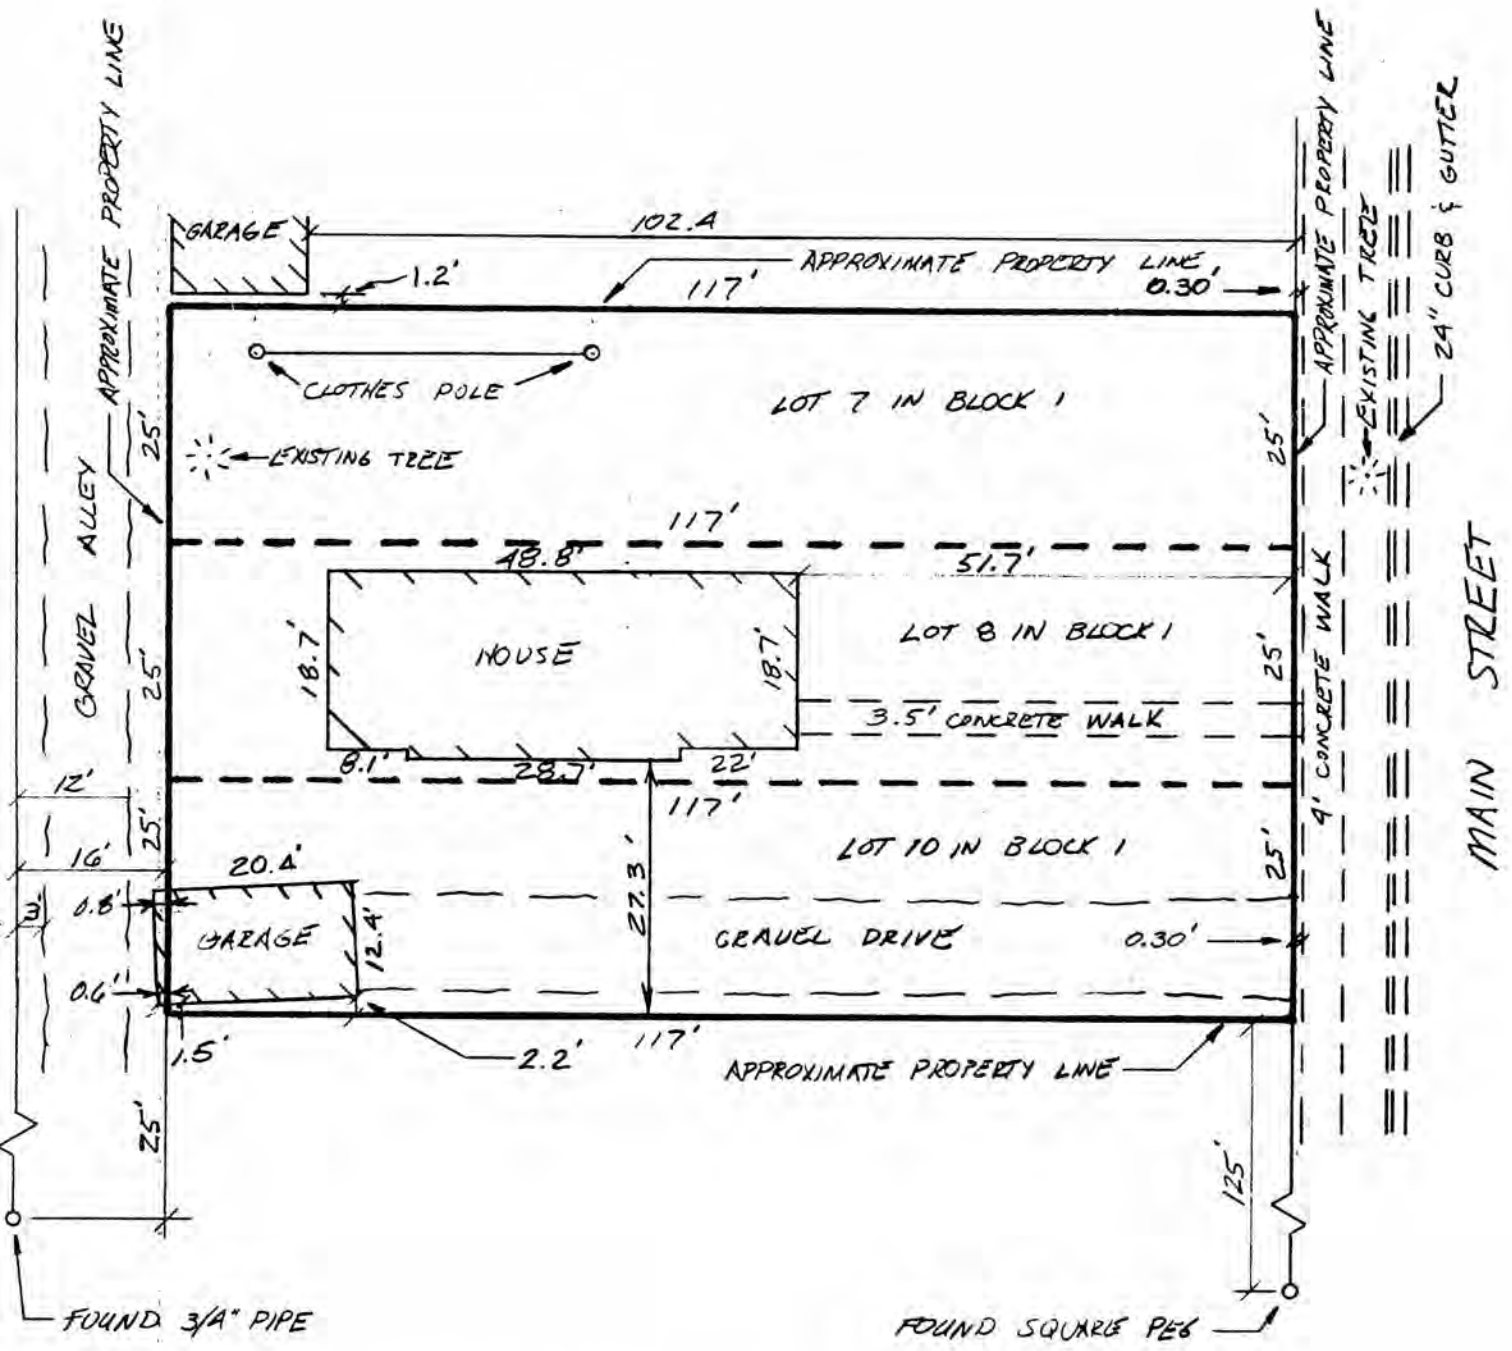

D. F. BURBACH MUNICIPAL & CIVIL ENGINEERS

5992 STATE HIGHWAY 80 SOUTH • PLATTEVILLE, WISCONSIN 53818 • (608) 348-3262

051

LEGAL DESCRIPTION:

Lots 7, 8, and 10, in Block 1, of Clemen's Addition to the Village (now City) of Cuba City, Grant Co., Wis., according to the recorded plat thereof.

SURVEYOR'S NOTE:

As clients of D. F. Burbach Municipal & Civil Engineers, I/we request that the inspection be made according to the following specifications:

- 1). Only enough work be performed to satisfy the requirements of the lending institution.
- 2). Only recorded (Deed) distances and bearings be shown.

It is specifically intended to exempt this inspection from the requirements of A-E 7.03, A-E 7.05(3) & (4) and A-E 7.06 of the Wisconsin Administrative Code, and is so stated and agreed to as required by A-E 7.01(2).

Tomak Lizard

Dated September 29, 1987

CERTIFICATE: I hereby certify that I have inspected the above described parcel and that the above map is a true representation thereof and shows the approximate location of the parcel, its recorded exterior boundaries, the location of all visible roadways and encroachments, if any. This inspection is made for the use of the purchasers' mortgage institution and is valid for one-half year from the date hereof.

Douglas J. Malliet

Douglas J. Malliet
S-1266
Registered Land Surveyor
September 29, 1987