


# MORTGAGE SURVEY 7

City of Platteville - Doscher's Addition

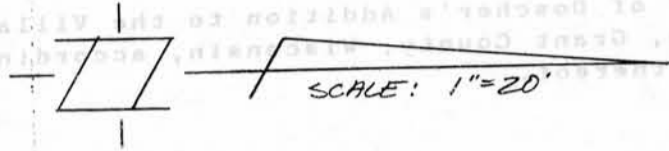

DEC 21 1990

APPROXIMATE PROPERTY LINES

ADJOINERS GARAGE

FND 1" IRON PIPE / (65.2' MEAS.) 1.0'

FND 1" IRON PIPE

1/6" TREE

CLOTHES LINES

LOT 10 BLOCK B  
DOSCHERS ADDITION

*Douglas J. Malliet*  
DOUGLAS J. MALLIET

S-1266

REGISTERED LAND SURVEYOR  
JANUARY 8, 1988

151.7' RBL.  
(151.5' MEAS.)

22.9'

3' WALK

EXISTING HOUSE

49.8'

28.7'

6" TREE

4' WALK

22.5'

24.3'

22.3'

4' WALK

75.0' RBL.

EXISTING GARAGE

17.6'

25.3'

GRAVEL & GRASS DRIVE

150.9' RBL.

12" TREE

12" TREE

3.0'

3.0'

3.0'

3.0'

APPROXIMATE PROPERTY LINES

EXISTING CURB & GUTTER  
FOURTH STREET



D. F. BURBACH MUNICIPAL & CIVIL ENGINEERS

5992 STATE HIGHWAY 80 SOUTH • PLATTEVILLE, WISCONSIN 53818 • (608) 348-3262

# MORTGAGE SURVEY

## LEGAL DESCRIPTION:

Lot Ten (10) in Block "B" of Doscher's Addition to the Village (now City) of Platteville, Grant County, Wisconsin, according to the recorded map or plat thereof.

## SURVEYOR'S NOTE:

As clients of D. F. Burbach Municipal & Civil Engineers, I/we request that the inspection be made according to the following specifications:

- 1). Only enough work be performed to satisfy the requirements of the lending institution.
- 2). Only recorded (Deed) distances and bearings be shown.

It is specifically intended to exempt this inspection from the requirements of A-E 7.03, A-E 7.05(3) & (4) and A-E 7.06 of the Wisconsin Administrative Code, and is so stated and agreed to as required by A-E 7.01(2).

*Marne K. Bloyer*

Dated January 8, 1988

CERTIFICATE: I hereby certify that I have inspected the above described parcel and that the above map is a true representation thereof and shows the approximate location of the parcel, its recorded exterior boundaries, the location of all visible roadways and encroachments, if any. This inspection is made for the use of the purchasers' mortgage institution and is valid for one-half year from the date hereof.

*Douglas J. Malliet*

Douglas J. Malliet  
S-1266  
Registered Land Surveyor  
January 8, 1988

