

MORTGAGE SURVEY 17


City of Platteville - Mound View Park Addition



DEC 21 1990

PITT STREET

EXISTING CURB + GUTTER

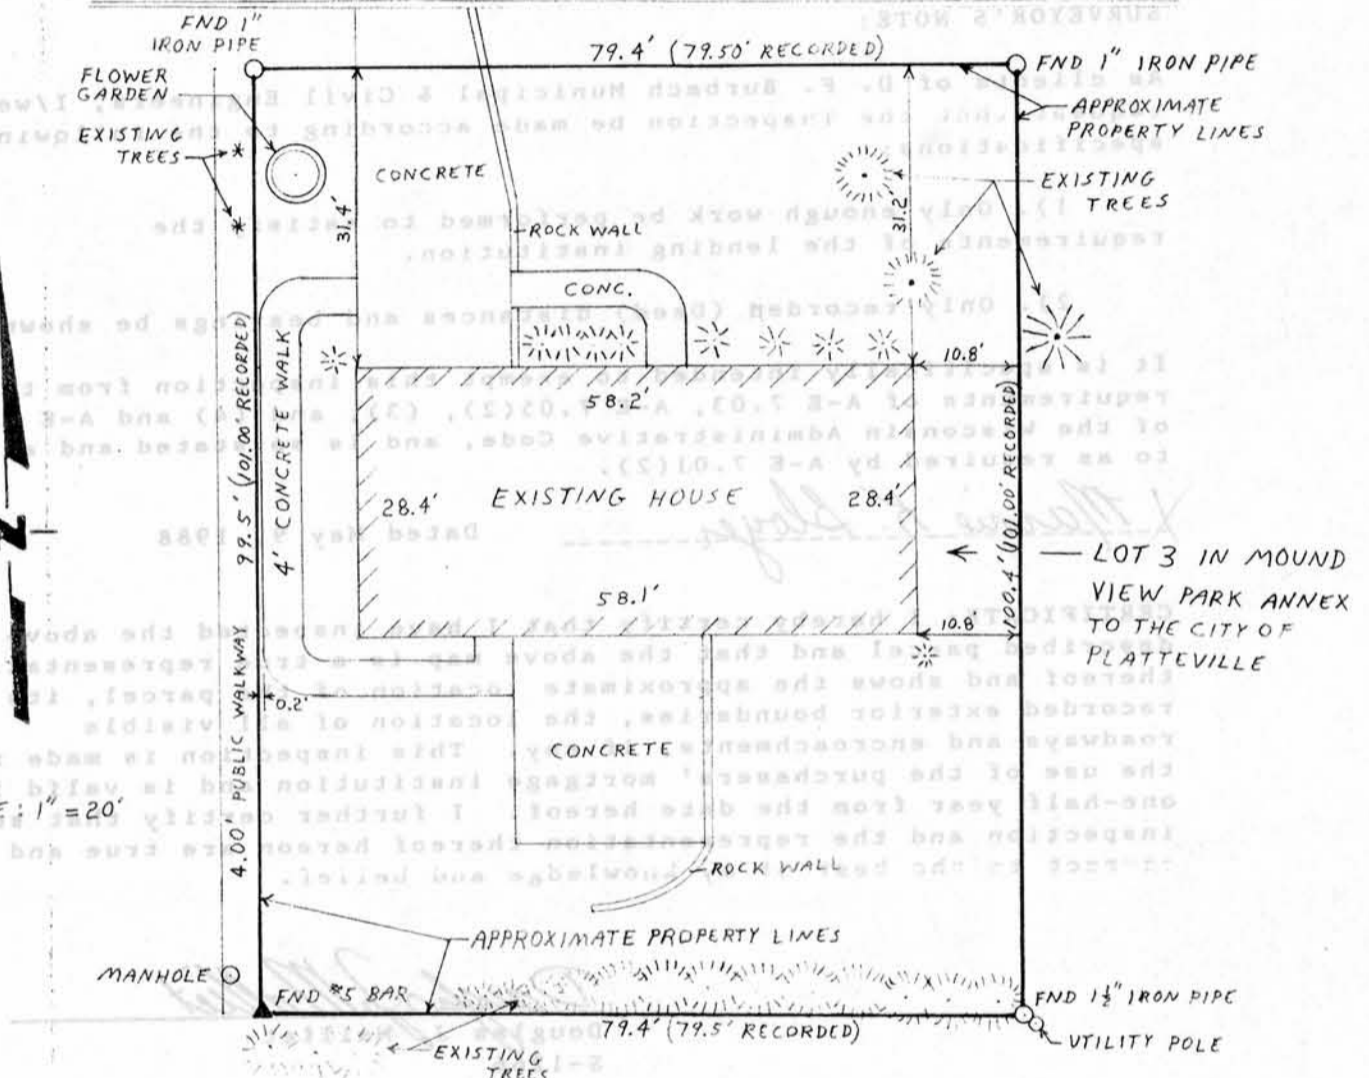

SCALE: 1" = 20'



Douglas J. Malliet
 DOUGLAS J. MALLIET
 S-1266
 REGISTERED LAND SURVEYOR
 MAY 9, 1988

D. F. BURBACH MUNICIPAL & CIVIL ENGINEERS

17

MORTGAGE SURVEY

RECEIVED
DEPT. OF REVENUE
MAY 10 1988

LEGAL DESCRIPTION:

Lot 3 in Mound View Park Annex to the City of Platteville.

SURVEYOR'S NOTE:

As clients of D. F. Burbach Municipal & Civil Engineers, I/we request that the inspection be made according to the following specifications:

- 1). Only enough work be performed to satisfy the requirements of the lending institution.
- 2). Only recorded (Deed) distances and bearings be shown.

It is specifically intended to exempt this inspection from the requirements of A-E 7.03, A-E 7.05(2), (3), and (4) and A-E 7.06 of the Wisconsin Administrative Code, and is so stated and agreed to as required by A-E 7.01(2).

Marnie K. Boyer

Dated May 9, 1988

CERTIFICATE: I hereby certify that I have inspected the above described parcel and that the above map is a true representation thereof and shows the approximate location of the parcel, its recorded exterior boundaries, the location of all visible roadways and encroachments, if any. This inspection is made for the use of the purchasers' mortgage institution and is valid for one-half year from the date hereof. I further certify that such inspection and the representation thereof hereon are true and correct to the best of my knowledge and belief.

Douglas J. Mallet

Douglas J. Mallet
S-1266
Registered Land Surveyor
May 9, 1988



D. F. BURBACH MUNICIPAL & CIVIL ENGINEERS

Box 96B, Highway 80 South • Platteville, Wisconsin 53818 • (608) 348-3262