

Village of Hazel Green - Mills Subdivision


GRANT COUNTY CLERK
RECEIVED
47

Richard S. Osborn, P.E. R.L.S.

217 Maureen Avenue
Dickeyville, Wisconsin 53808
(608) 568-7995

CHICAGO STREET
MAR 27 1991

August 29, 1977

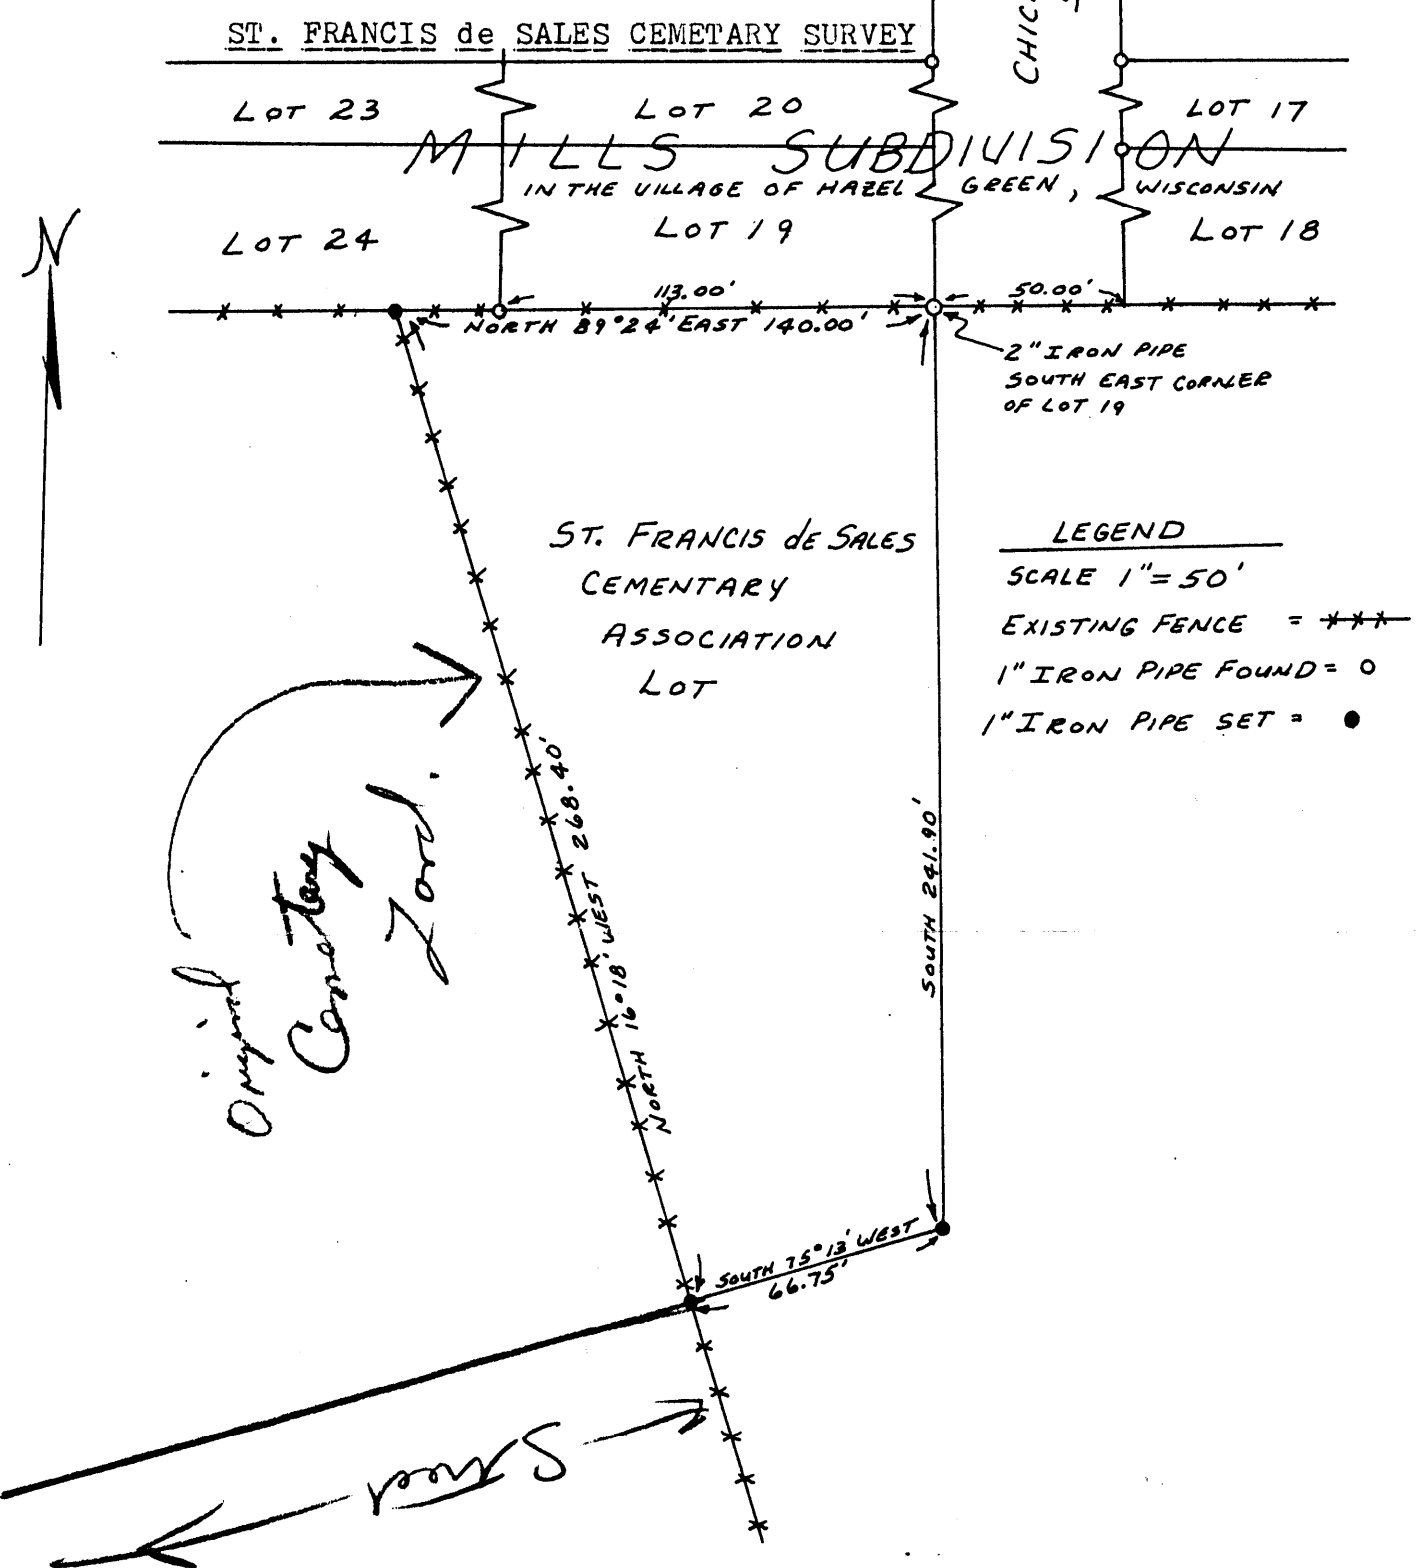

Commencing and beginning at the Southeast Corner of Lot 19 in the Mill's Subdivision in the Village of Hazel Green, Wisconsin;

Thence South 241.90 feet;

Thence South 75°13' West 66.75 feet;

Thence North 16°18' West 268.40 feet;

Thence North 89°24' East 140.00 feet

to the Point of Beginning; containing 0.59 Acres more or less.

I, Richard Scott Osborn, Registered Surveyor, hereby certify that I have surveyed the above described tract of land and that the above plat is correct and true representation of the land surveyed.

Date 8/30/77

Richard Scott Osborn

Richard Scott Osborn
R.L.S. 1233