
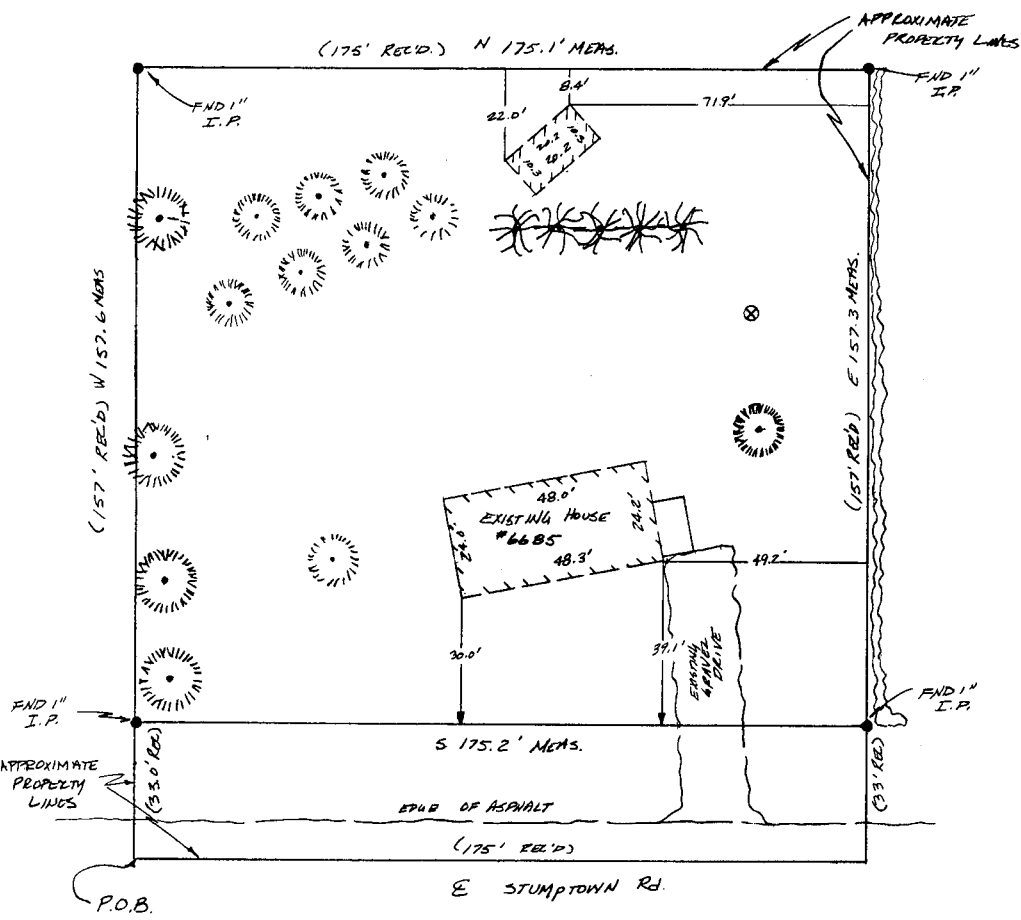


Sec 7, T3N R1W

REC'D

86

# MORTGAGE SURVEY JUN 3 1991

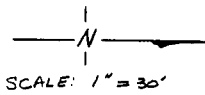

*David F. Burbach*  
DAVID F. BURBACH  
S-2019  
REGISTERED LAND SURVEYOR  
APRIL 26, 1991

**D. F. BURBACH MUNICIPAL & CIVIL ENGINEERS**

5992 STATE HIGHWAY 80 SOUTH • PLATTEVILLE, WISCONSIN 53818 • (608) 348-3262

Page / of 2

18

LEGAL DESCRIPTION:

Part of the S.W. 1/4 of N.W. 1/4 of Section 7, T 3 N, R 1 W of the 4th P.M., Grant County, Wisconsin, described as follows, to-wit: Commencing at the Southeast corner of said S.W. 1/4 of N.W. 1/4, being the centerline of Stumptown Road and also the point of beginning; thence West 33.00 feet to the West line of said Stumptown Road; thence West 157.00 feet; thence North 175.00 feet; thence East 157.00 feet to the West line of said town road; thence continuing East 33.00 feet to the center of said town road; thence South 175.00 feet along centerline of said town road to point of beginning.

SURVEYOR'S NOTE:

As clients of D. F. Burbach Municipal & Civil Engineers, I/we request that the inspection be made according to the following specifications:

- 1). Only enough work be performed to satisfy the requirements of the lending institution.
- 2). Only recorded (Deed) distances and bearings be shown.

It is specifically intended to exempt this inspection from the requirements of A-E 7.03, A-E 7.05(2), (3), and (4) and A-E 7.06 of the Wisconsin Administrative Code, and is so stated and agreed to as required by A-E 7.01(2).

*Neil A. Loenz*

Dated April 26, 1991

CERTIFICATE: I hereby certify that I have inspected the above described parcel and that the above map is a true representation thereof and shows the approximate location of the parcel, its recorded exterior boundaries, the location of all visible roadways and encroachments, if any. This inspection is made for the use of the purchasers' mortgage institution and is valid for one-half year from the date hereof. I further certify that such inspection and the representation thereof hereon are true and correct to the best of my knowledge and belief.

*David F. Burbach*

David F. Burbach  
S-2019  
Registered Land Surveyor  
April 26, 1991

