

Sec 9, T5N, R2W
105

MORTGAGE INSPECTION SURVEY

FOR: ANCHOR SAVINGS AND LOAN ASSOC.
LANCASTER, WISCONSIN

RON & MARY BAST
11685 MAIN ST.
STEELE, WI.

STATEMENTS REGARDING WORK TO BE DONE:

- AS CLIENT(S) OF LARRY L. AUSTIN, WISCONSIN LAND SURVEYOR, I/WE HEREBY REQUEST THAT THE SURVEY BE MADE ACCORDING TO THE FOLLOWING SPECIFICATIONS:
- 1) ONLY ENOUGH WORK BE PERFORMED TO SATISFY THE REQUIREMENTS OF ANCHOR SAVINGS AND LOAN ASSOC. OF LANCASTER, WI.
 - 2) NO STAKES BE SET TO MARK THE CORNERS OF THE PARCEL.
 - 3) THE EXACT LENGTH AND BEARINGS OF THE BOUNDARIES OF THE PARCEL NEED NOT BE SHOWN.
 - 4) MEASUREMENTS NEED NOT BE TAKEN AS SPECIFIED IN A-E 7.06 OF THE WISCONSIN ADMINISTRATIVE CODE. IT IS SPECIFICALLY INTENDED TO EXEMPT THIS SURVEY FROM THE REQUIREMENTS OF A-E 7.05 (3), 7.06 AND A-E 7.07 OF THE WISCONSIN ADMINISTRATIVE CODE.


DATE _____

SURVEYOR'S CERTIFICATE: I HEREBY CERTIFY THAT I HAVE SURVEYED THE ABOVE PARCEL AND THAT THE MAP SHOWN HEREON IS A TRUE AND CORRECT REPRESENTATION THEREOF TO THE BEST OF MY KNOWLEDGE AND BELIEF, AND SHOWS THE SIZE AND LOCATION OF THE PARCEL, IT'S RECORDED EXTERIOR BOUNDARIES, THE LOCATION OF VISIBLE ROADWAYS AND ENCROACHMENTS, IF ANY. THIS SURVEY IS MADE FOR THE USE OF THE PRESENT OWNERS OF THE PROPERTY AND THOSE WHO PURCHASE, MORTGAGE, OR GUARANTEE TITLE THERETO WITHIN ONE YEAR FROM THE DATE HEREON.

Larry L. Austin
LARRY L. AUSTIN, RLS 1903

DATE 4/29/90

LARRY AUSTIN ENGINEERING
RT. 2
LANCASTER, WISCONSIN 53813
PHONE (608) 723-6363

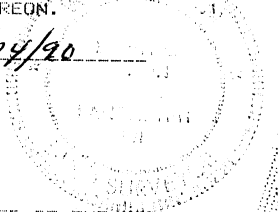

DESCRIPTION PROVIDED: COMMENCING AT THE NORTHWEST CORNER OF THE NORTHWEST QUARTER (N.W. 1/4) OF THE NORTHWEST QUARTER (N.W. 1/4) OF SECTION NINE (9), TOWNSHIP FIVE (5) NORTH, RANGE TWO (2) WEST OF THE 4TH P.M. IN GRANT COUNTY, WISCONSIN; THENCE SOUTH 36 RODS 14 FEET; THENCE EAST 42 RODS 7 FEET MORE OR LESS TO THE WESTERLY RIGHT OF WAY OF COUNTY TRUNK HIGHWAY "F"; THENCE NORTH ALONG THE WESTERLY RIGHT OF WAY OF SAID HIGHWAY 318 FEET TO THE POINT OF BEGINNING; THENCE WEST 150 FEET; THENCE NORTH 134 FEET; THENCE EAST 150 FEET TO THE WESTERLY RIGHT OF WAY OF SAID HIGHWAY; THENCE SOUTH 134 FEET TO THE POINT OF BEGINNING.

