


MORTGAGE SURVEY

OCT 17 2019

SCALE: 1" = 10'

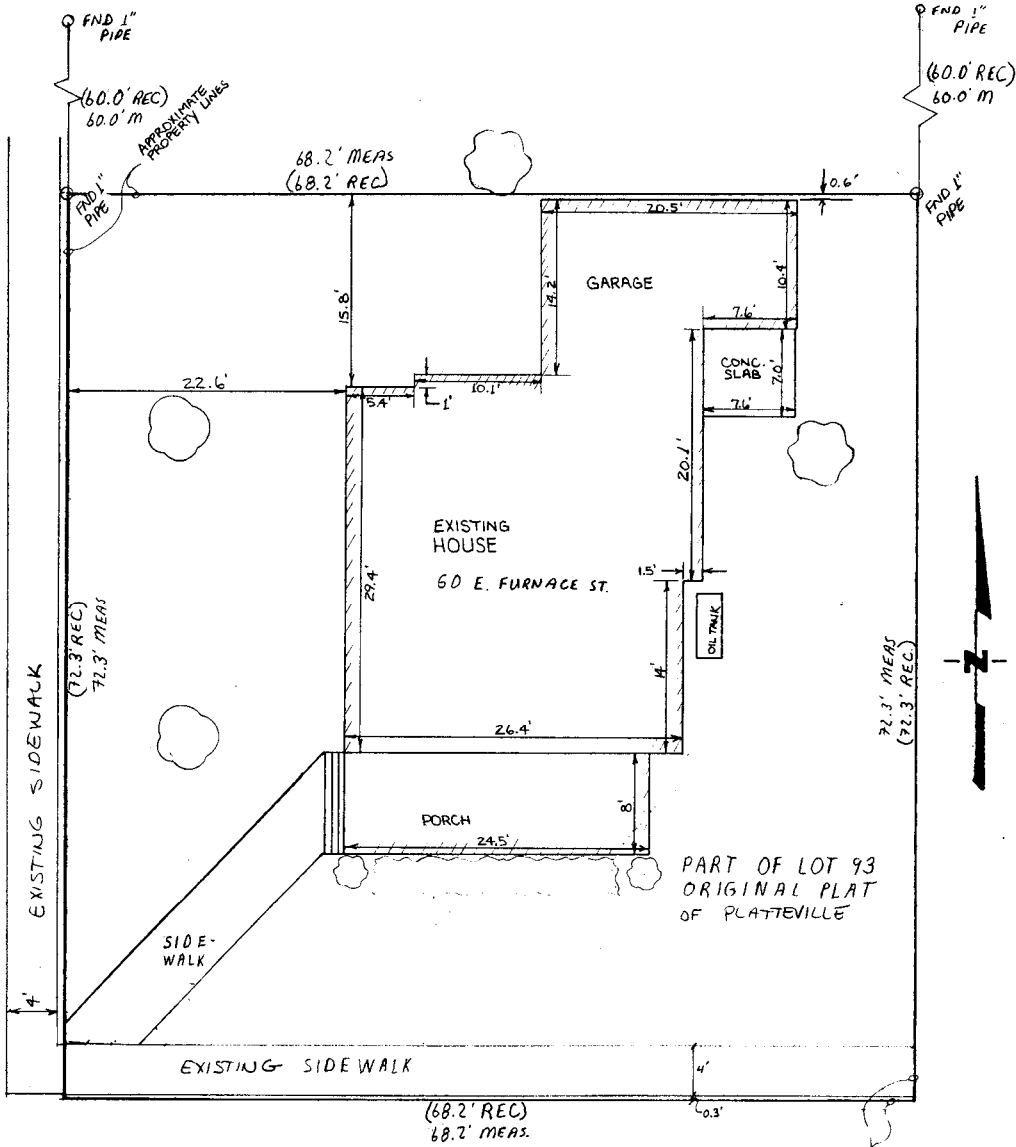

David F. Burbach
 DAVID F. BURBACH
 S-2019 REGISTERED LAND SURVEYOR
 OCTOBER 9, 1991

D. F. BURBACH MUNICIPAL & CIVIL ENGINEERS

5992 STATE HIGHWAY 80 SOUTH • PLATTEVILLE, WISCONSIN 53818 • (608) 348-3262

Page 1 of 2

LEGAL DESCRIPTION:


Commencing at the Southwest corner of Lot Ninety-three (93) of the Original Plat to the City of Platteville, Grant County, Wisconsin; thence South 72° 29' East 68 feet 2 inches along the North boundary line of Furnace Street; thence North 17° 00' East 66 feet 3 1/2 inches; thence North 72° 29' West 68 feet 2 inches to the East line of Third Street; thence South 17° 00' West 66 feet 3 1/2 inches along said East line to the point of beginning. Also the following described strip of land: Commencing at the Southwest corner of Lot Ninety-three (93) of the Original Plat to the City of Platteville, Grant County, Wisconsin; thence North 17° 00' East 66 feet 3 1/2 inches along the East line of Third Street to the point of beginning; thence South 72° 29' East 68 feet 2 inches; thence North 17° 00' East 6.00 feet; thence North 72° 29' West 68 feet 2 inches to the East line of Third Street; thence South 17° 00' West 6.00 feet along said East line to the point of beginning. All of the above descriptions being a part of Lots Ninety-three (93) and Ninety-four (94) to the Original Plat to the City of Platteville, Grant County, Wisconsin, according to the recorded map or plat thereof.

SURVEYOR'S NOTE:

As clients of D. F. Burbach Municipal & Civil Engineers, I/we request that the inspection be made according to the following specifications:


- 1). Only enough work be performed to satisfy the requirements of the lending institution:
- 2). Only recorded (Deed) distances and bearings be shown.

It is specifically intended to exempt this inspection from the requirements of A-E 7.03, A-E 7.05(2), (3), and (4) and A-E 7.06 of the Wisconsin Administrative Code, and is so stated and agreed to as required by A-E 7.01(2).

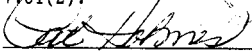

Dated October 9, 1991

CERTIFICATE: I hereby certify that I have inspected the above described parcel and that the above map is a true representation thereof and shows the approximate location of the parcel, its recorded exterior boundaries, the location of all visible roadways and encroachments, if any. This inspection is made for the use of the purchasers' mortgage institution and is valid for one-half year from the date hereof. I further certify that such inspection and the representation thereof hereon are true and correct to the best of my knowledge and belief.

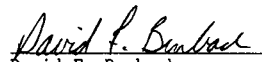
David F. Burbach
S-2019
Registered Land Surveyor
October 9, 1991



D. F. BURBACH MUNICIPAL & CIVIL ENGINEERS

5992 STATE HIGHWAY 80 SOUTH • P.O. BOX 721 • PLATTEVILLE, WISCONSIN 53818 • (608) 348-3262 • FAX (608) 348-4970