


Sec 27, T2N, R2W
MORTGAGE SURVEY

68

DEC 31 1991

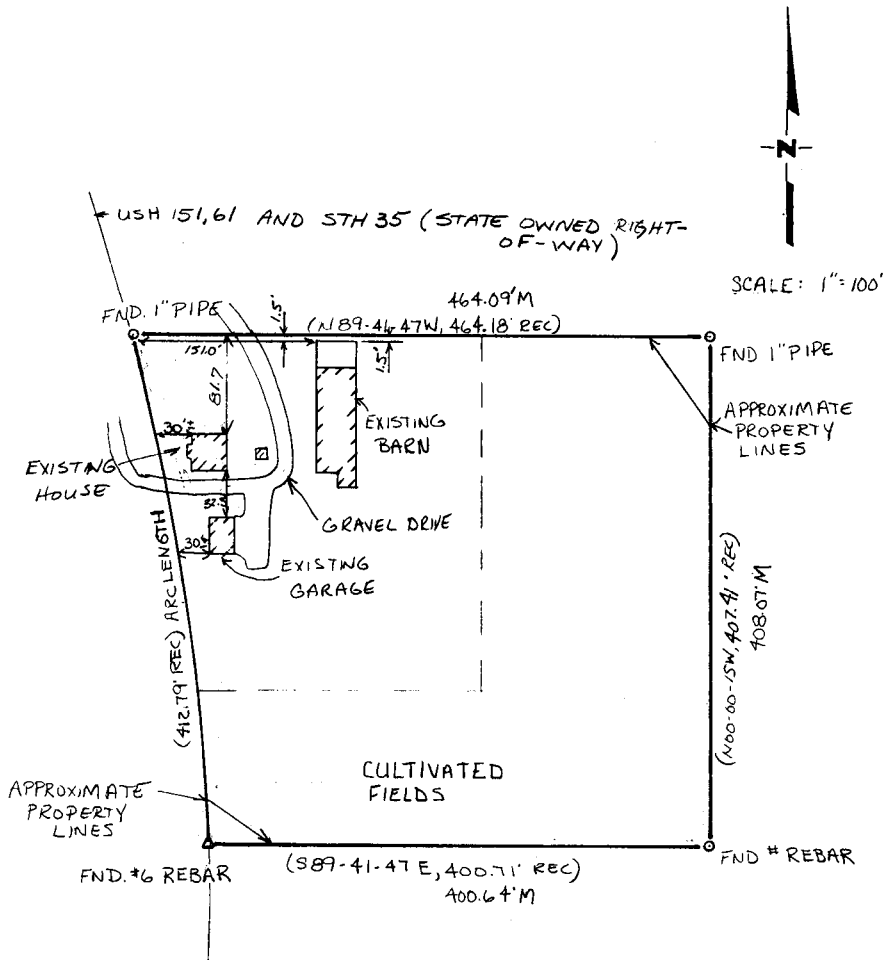

Keith E. Dalsing
 KEITH E. DALRING
 S-1989
 REGISTERED LAND SURVEYOR
 DECEMBER 17, 1991

D. F. BURBACH MUNICIPAL & CIVIL ENGINEERS

5992 STATE HIGHWAY 80 SOUTH • PLATTEVILLE, WISCONSIN 53818 • (608) 348-3262

Page / of 2

82

LEGAL DESCRIPTION:


Part of the S.E. 1/4 of N.E. 1/4 of Section 27, T2N, R2W of the 4th P.M., Grant County, Wisconsin, described as follows, to-wit: Beginning at the Southeast corner of Certified Survey Map No. 138 recorded in the Office of the Register of Deeds for Grant County, Wisconsin as Document No. 472959; thence North 89° 41' 47" West 484.58 feet along the Southerly line of said Certified Survey Map to the Easterly right-of-way line of U.S. Highway #151, said point being on the arc of a curve concave Westerly, having a radius of 3929.83 feet; thence Southerly 507.07 feet along the arc of said right-of-way line to a point on the same, said arc having a chord which bears South 09° 31' 52" East 506.72 feet and a central angle of 07° 23' 35"; thence South 89° 41' 47" East 400.71 feet; thence North 00° 00' 15" West 499.28 feet to the point of beginning; EXCEPTING therefrom Beginning at the Southeast corner of said Certified Survey Map; thence South 00° 00' 15" East 91.87 feet; thence North 89° 41' 47" West 464.18 feet to a point on the Easterly right-of-way line of U.S. Highway #151, said point also being the point of curvature of a curve to the left having a central angle of 01° 21' 39" and a radius of 3966.83 feet; thence Northwesterly 94.21 feet along the arc of the curve to the point of tangency thereof, the long chord which bears North 12° 30' 33" West 94.12 feet; thence South 89° 41' 47" East 484.58 feet to the point of beginning.

SURVEYOR'S NOTE:

As clients of D. F. Burbach Municipal & Civil Engineers, I/we request that the inspection be made according to the following specifications:

- 1). Only enough work be performed to satisfy the requirements of the lending institution.
- 2). Only recorded (Deed) distances and bearings be shown.


It is specifically intended to exempt this inspection from the requirements of A-E 7.03, A-E 7.05(2), (3), and (4) and A-E 7.06 of the Wisconsin Administrative Code, and is so stated and agreed to as required by A-E 7.01(2).

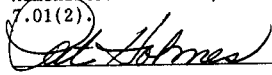

Dated December 17, 1991

CERTIFICATE: I hereby certify that I have inspected the above described parcel and that the above map is a true representation thereof and shows the approximate location of the parcel, its recorded exterior boundaries, the location of all visible roadways and encroachments, if any. This inspection is made for the use of the purchasers' mortgage institution and is valid for one-half year from the date hereof. I further certify that such inspection and the representation thereof hereon are true and correct to the best of my knowledge and belief.

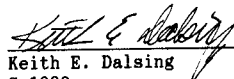


Keith E. Dalsing
S-1989
Registered Land Surveyor
December 17, 1991

D. F. BURBACH MUNICIPAL & CIVIL ENGINEERS

5992 STATE HIGHWAY 80 SOUTH • P.O. BOX 721 • PLATTEVILLE, WISCONSIN 53818 • (608) 348-3262 • FAX (608) 348-4970