

LEGEND

- IRON PIPE FOUND
- IRON ROD SET
- (R) RECORDED DIMENSION (DISTANCE & BEARING AS NOTED)
- PROPERTY LINE
- - - SECTION LINE
- CORPORATION LINE
- ⊥ CENTERLINE

SURVEY FOR
CRAWFORD MINING CO., HAZEL GREEN, WISCONSIN

ACCESS EASEMENT DESCRIPTION

Beginning at a point on the South Corporation Line of the Village of Hazel Green, Wisconsin, which is 1,678.58 feet South and 1,711.27 feet West of the N.E. Corner of the S.E. 1/4 of Sec. 25, T1N, R1W of the 4th P.M., Grant County, Wisconsin;


thence North 6°46'29" West 277.10 feet to a point;
 thence South 89°26'00" East 127.81 feet to a point;
 thence South 56°16'05" East 172.22 feet to a point;
 thence South 73°58'27" East 117.06 feet to a point;
 thence South 62°44'32" East 139.45 feet to a point;
 thence North 88°16'00" East 196.25 feet to a point;
 thence South 1°44'00" East 285.00 feet to a point;
 thence South 88°16'00" West 196.25 feet to a point;
 thence North 1°44'00" West 222.00 feet to the point of beginning, containing 5.00 acres, more or less.

Beginning at a point which is 1,051.46 feet South and 1,711.27 feet West of the N.E. Corner of the S.E. 1/4 of Sec. 25, T1N, R1W of the 4th P.M., Grant County, Wisconsin;

thence South 6°46'29" East 60.50 feet to a point;
 thence North 89°26'00" West 198.50 feet to the point of intersection with the Easterly right-of-way of State Highway #80;
 thence North 8°10'30" West 60.71 feet along said Easterly right-of-way of State Highway #80 to a point;
 thence South 89°26'00" East 200.00 feet to the point of beginning, containing 0.27 acres, more or less.

I hereby certify the above survey and plat was made under my direct personal supervision and is correct to the best of my knowledge and belief.

FEB 5 1992

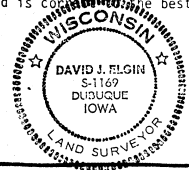

David J. Elgin
 David J. Elgin
 11-19-84

Drawn	N/A	Field Book No.	
Date	11/19/84	Plat No.	150
Checked	DJE	Reviewed	DJE
Checked	DJE	Reviewed	DJE

SHIVE-HATTERY ENGINEERS
 Civil Engineers - Iowa City - Waterloo
 Des Moines - Dubuque - Davenport - Rock Island



SURVEY OF PART OF THE SE 1/4 SEC. 25, T1N, R1W OF THE 4TH P.M. - HAZEL GREEN TWP., GRANT CO., WISCONSIN

Sheet: 1 of 1
 Drawing No: 184272-2