


City of Platteville

Sunset Acres Subdivision

91

MORTGAGE SURVEY

MAR 5 1992

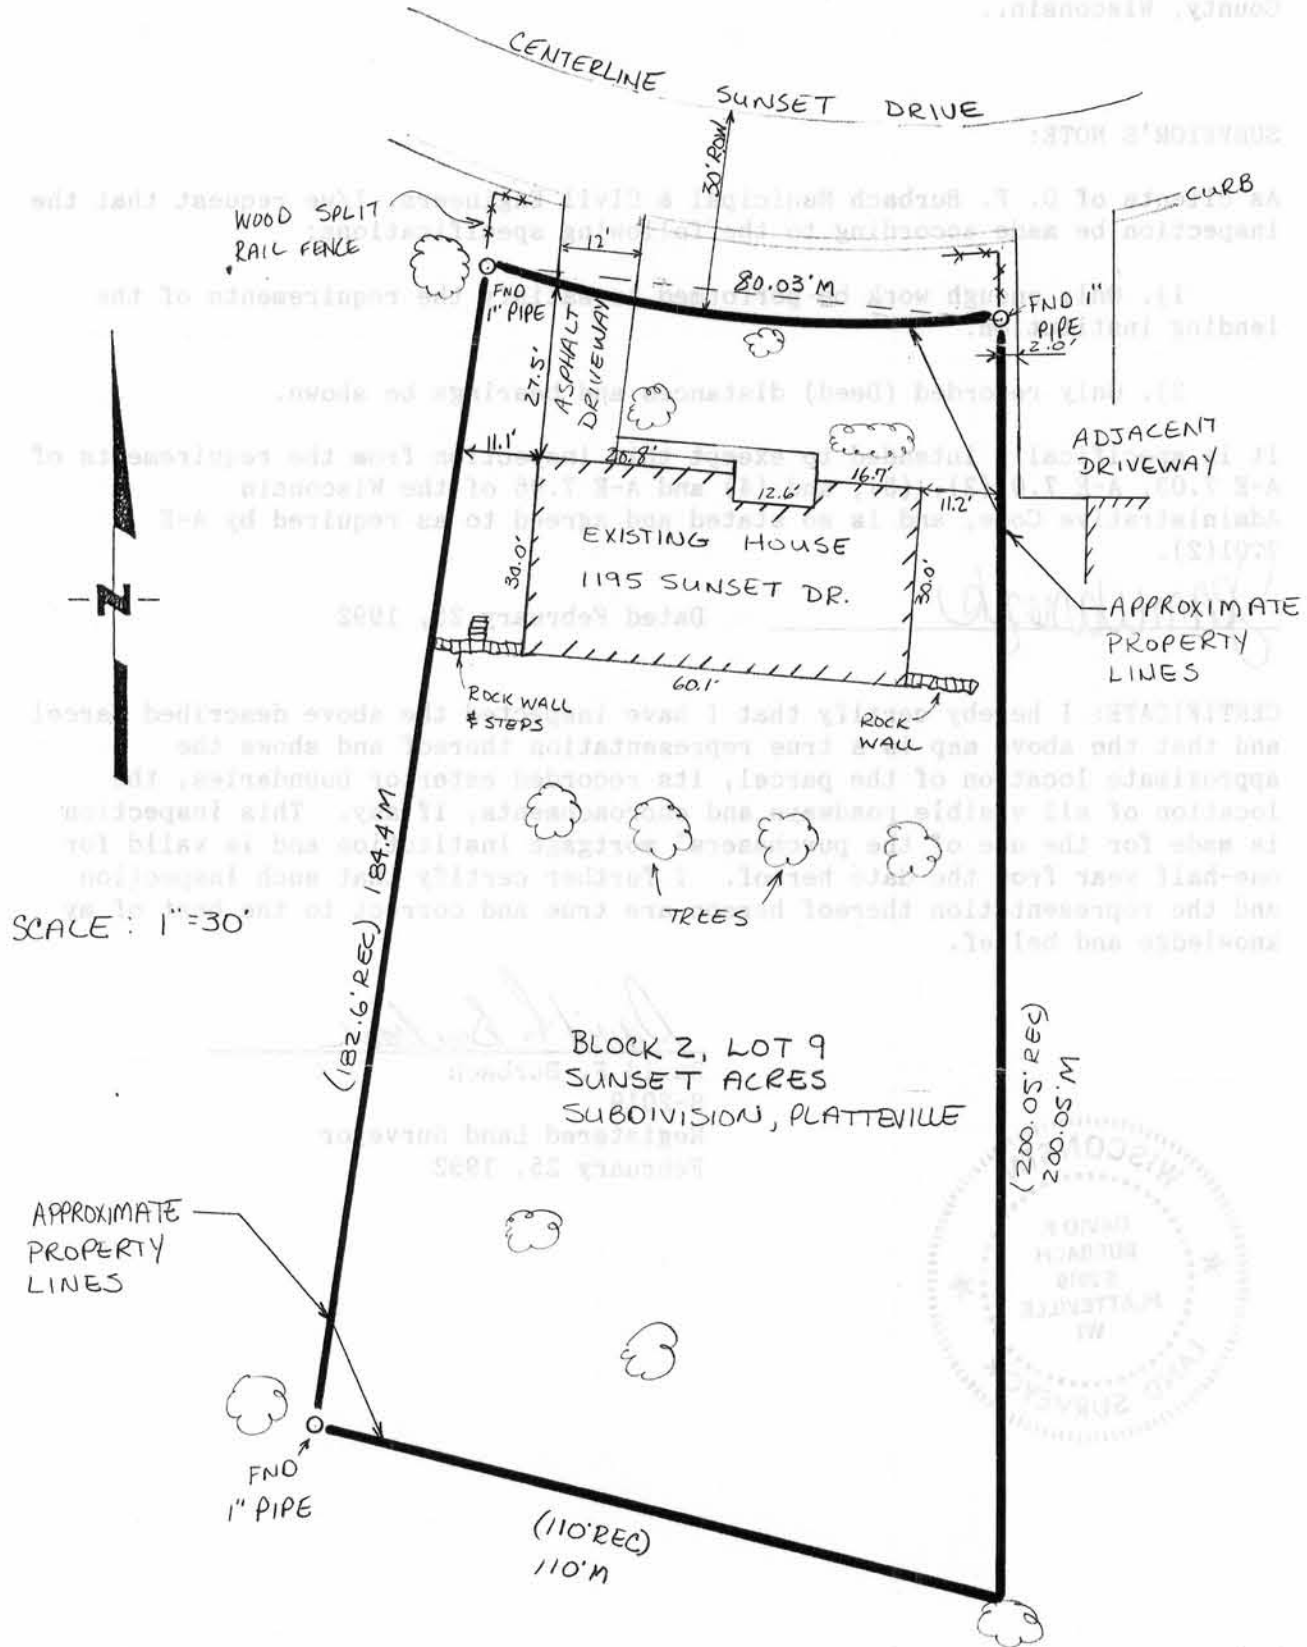

SCALE: 1"=30'

APPROXIMATE PROPERTY LINES



David F. Burbach

DAVID F. BURBACH
 S-2019
 REGISTERED LAND SURVEYOR
 FEBRUARY 25, 1992

19

MORTGAGE SURVEY

LEGAL DESCRIPTION:

Block 2, Lot 9, of Sunset Acre Subdivision in the City of Platteville, Grant County, Wisconsin..

SURVEYOR'S NOTE:

As clients of D. F. Burbach Municipal & Civil Engineers, I/we request that the inspection be made according to the following specifications:

- 1). Only enough work be performed to satisfy the requirements of the lending institution.
- 2). Only recorded (Deed) distances and bearings be shown.

It is specifically intended to exempt this inspection from the requirements of A-E 7.03, A-E 7.05(2), (3), and (4) and A-E 7.06 of the Wisconsin Administrative Code, and is so stated and agreed to as required by A-E 7.01(2).

Jean Wanzek

Dated February 25, 1992

CERTIFICATE: I hereby certify that I have inspected the above described parcel and that the above map is a true representation thereof and shows the approximate location of the parcel, its recorded exterior boundaries, the location of all visible roadways and encroachments, if any. This inspection is made for the use of the purchasers' mortgage institution and is valid for one-half year from the date hereof. I further certify that such inspection and the representation thereof hereon are true and correct to the best of my knowledge and belief.

David F. Burbach

David F. Burbach
S-2019
Registered Land Surveyor
February 25, 1992



D. F. BURBACH MUNICIPAL & CIVIL ENGINEERS