

Sec 15, T6N, R3W

124

BENCHMARK SURVEYS, INC.

P.O. BOX 486 608/647-8533
RICHLAND CENTER, WISCONSIN 53581

**REPORT OF
MORTGAGE INSPECTION
FOR**



SURVEYING—PLANNING



SCALE 1" = 200'

F. & M. BANK - FENNIMORE


FURNISHED DESCRIPTION

A triangular plot of ground approximately 5 acres in size in the Northeast Corner of the Northeast One Quarter of the Southwest One Quarter of Section Fifteen, Town Six North, Range Three West of the 4th P.M. in Grant County, Wisconsin, being all that portion of said Quarter-Quarter lying North and East of the Town Road running through the Northeast Corner of said Quarter-Quarter.



MAR 11 1992

NE/SW
SECTION 15

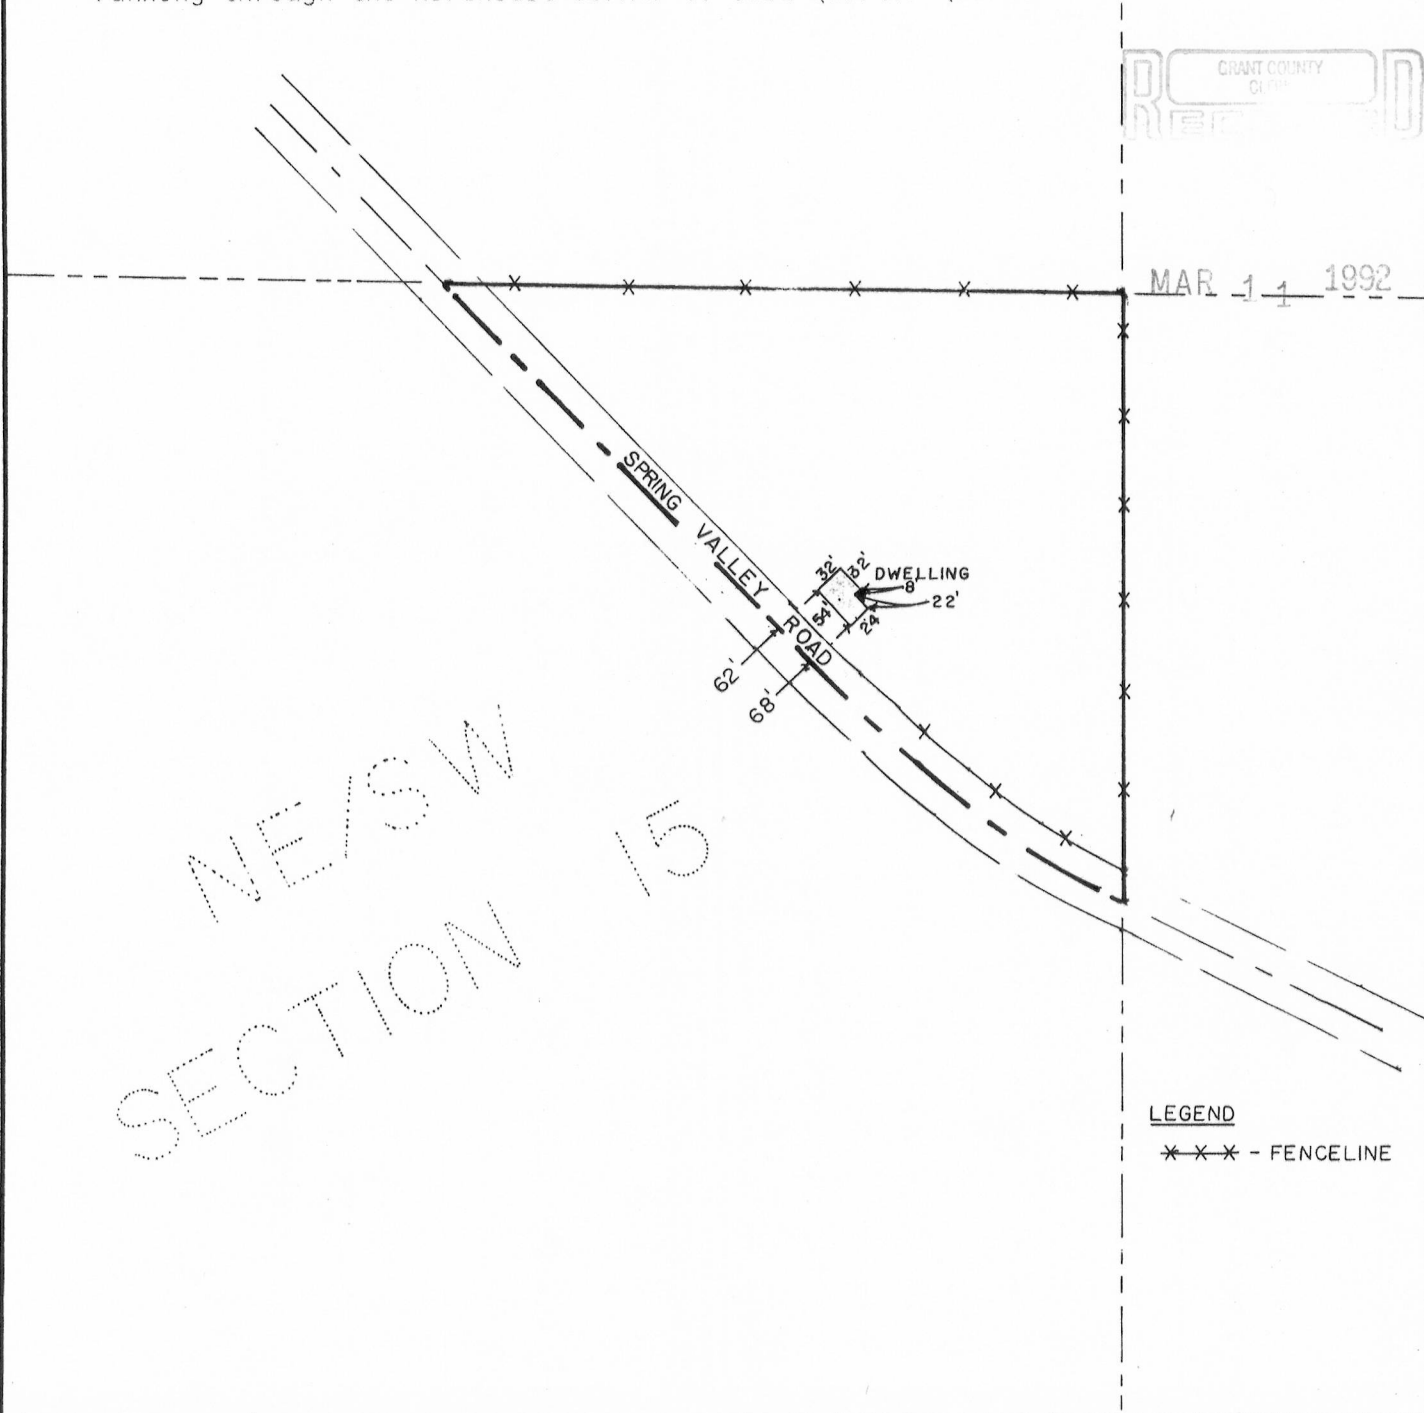

LEGEND
* * * - FENCELINE

WAIVER

WE HEREBY AGREE TO EXCLUDE THE SURVEYING REQUIREMENTS OUTLINED IN s.A-E 7.03, s.A-E 7.04, s.A-E 7.06 and s.A-E 7.07 of the Wisconsin Administrative Code.

OWNER/AGENT

DATE

OWNER/AGENT

DATE

"I HAVE INSPECTED THE ABOVE DESCRIBED PROPERTY, AND THE ABOVE MAP IS A TRUE REPRESENTATION THEREOF AND SHOWS THE SIZE AND LOCATION OF THE PROPERTY, ITS EXTERIOR BOUNDARIES, THE LOCATION AND DIMENSIONS OF ALL STRUCTURES THEREON, FENCES, ROADWAYS, APPARENT EASEMENTS AND ENCROACHMENTS, IF ANY.

THIS REPORT IS MADE FOR THE EXCLUSIVE USE OF THE PRESENT OWNERS OF THE PROPERTY, AND ALSO THOSE WHO PURCHASE, MORTGAGE OR GUARANTEE THE TITLE THEREOF, WITHIN ONE (1) YEAR FROM DATE HEREOF: AND AS TO THEM I HEREBY CERTIFY THAT SAID REPORT AND THE ABOVE MAP WERE MADE IN ACCORDANCE WITH ACCEPTABLE PROFESSIONAL STANDARDS AND THAT THE INFORMATION CONTAINED HEREON IS, TO THE BEST OF MY KNOWLEDGE, INFORMATION AND BELIEF A TRUE AND ACCURATE REPRESENTATION THEREOF."

DATED JANUARY 15, 1992

