



MORTGAGE SURVEY

NOV 3 1992

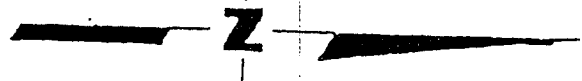

SCALE: 1" = 20'

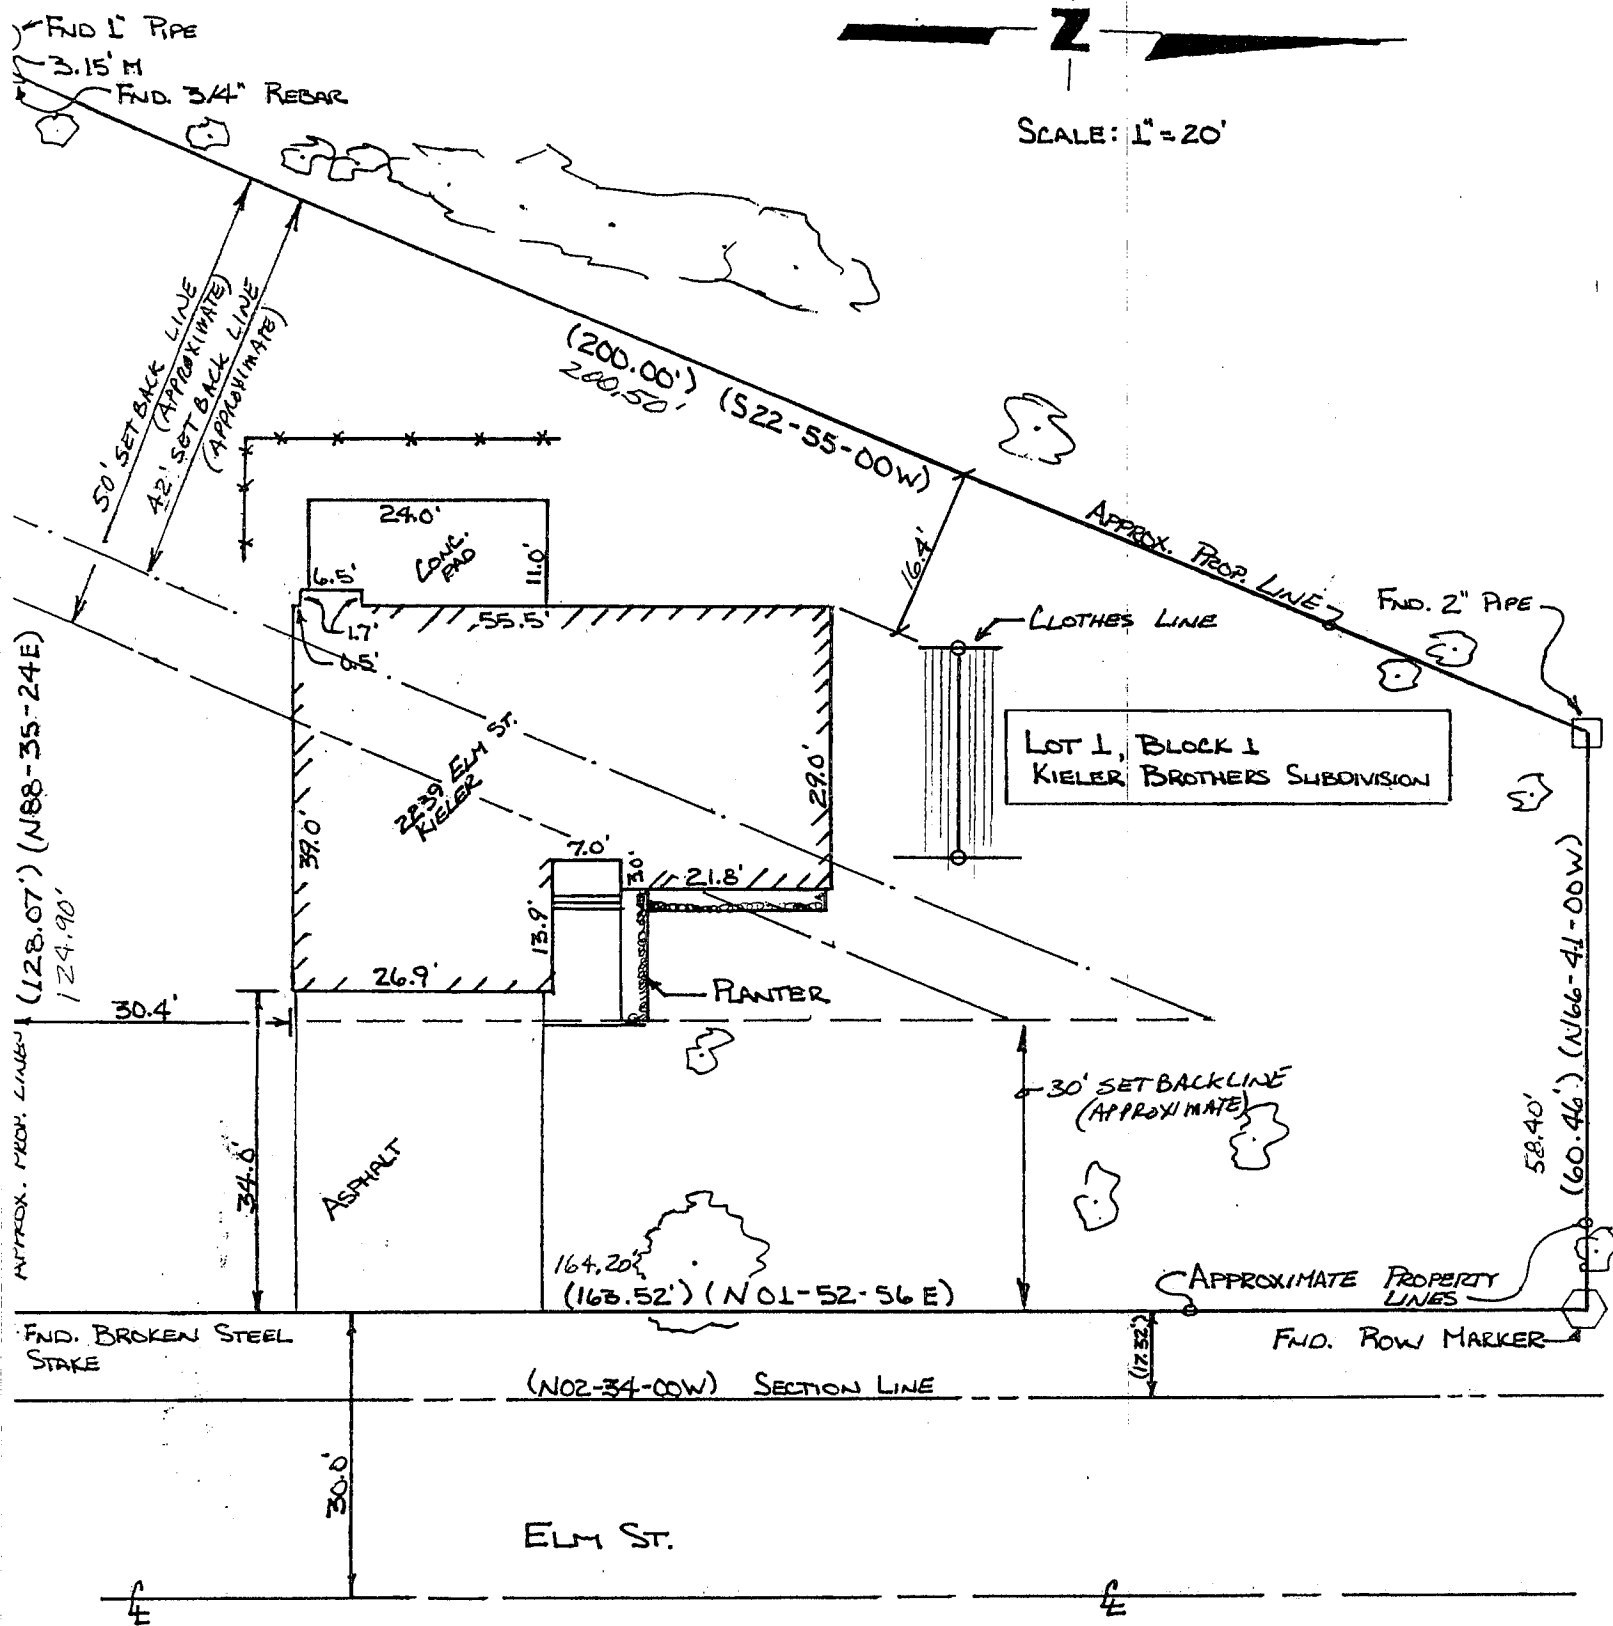

David F. Burbach
 David F. Burbach
 S-2019
 Registered Land Surveyor
 August 31, 1992
 REVISED 9/15/92
 REVISED 10/1/92

D. F. BURBACH MUNICIPAL & CIVIL ENGINEERS

LEGAL DESCRIPTION:

Lot 1, Block 1 of Kieler Brothers Subdivision located in the East 1/2 of the S.E. 1/4 of Section 4, T 1 N, R 2 W of the 4th P.M., Grant County, Wisconsin, according to the recorded map or plat thereof.

SURVEYOR'S NOTE:

As clients of D. F. Burbach Municipal & Civil Engineers, I/we request that the inspection be made according to the following specifications:

- 1). Only enough work be performed to satisfy the requirements of the lending institution.
- 2). Only recorded (Deed) distances and bearings be shown.

It is specifically intended to exempt this inspection from the requirements of A-E 7.03, A-E 7.05(2), (3), and (4) and A-E 7.06 of the Wisconsin Administrative Code, and is so stated and agreed to as required by A-E 7.01(2).

X Arthur A. Knowler

Dated August 31, 1992

CERTIFICATE: I hereby certify that I have inspected the above described parcel and that the above map is a true representation thereof and shows the approximate location of the parcel, its recorded exterior boundaries, the location of all visible roadways and encroachments, if any. This inspection is made for the use of the purchasers' mortgage institution and is valid for one-half year from the date hereof. I further certify that such inspection and the representation thereof hereon are true and correct to the best of my knowledge and belief.



David F. Burbach
David F. Burbach
S-2019
Registered Land Surveyor
August 31, 1992
REVISED 9/15/92
REVISED 10/1/92

D. F. BURBACH MUNICIPAL & CIVIL ENGINEERS