


MORTGAGE SURVEY

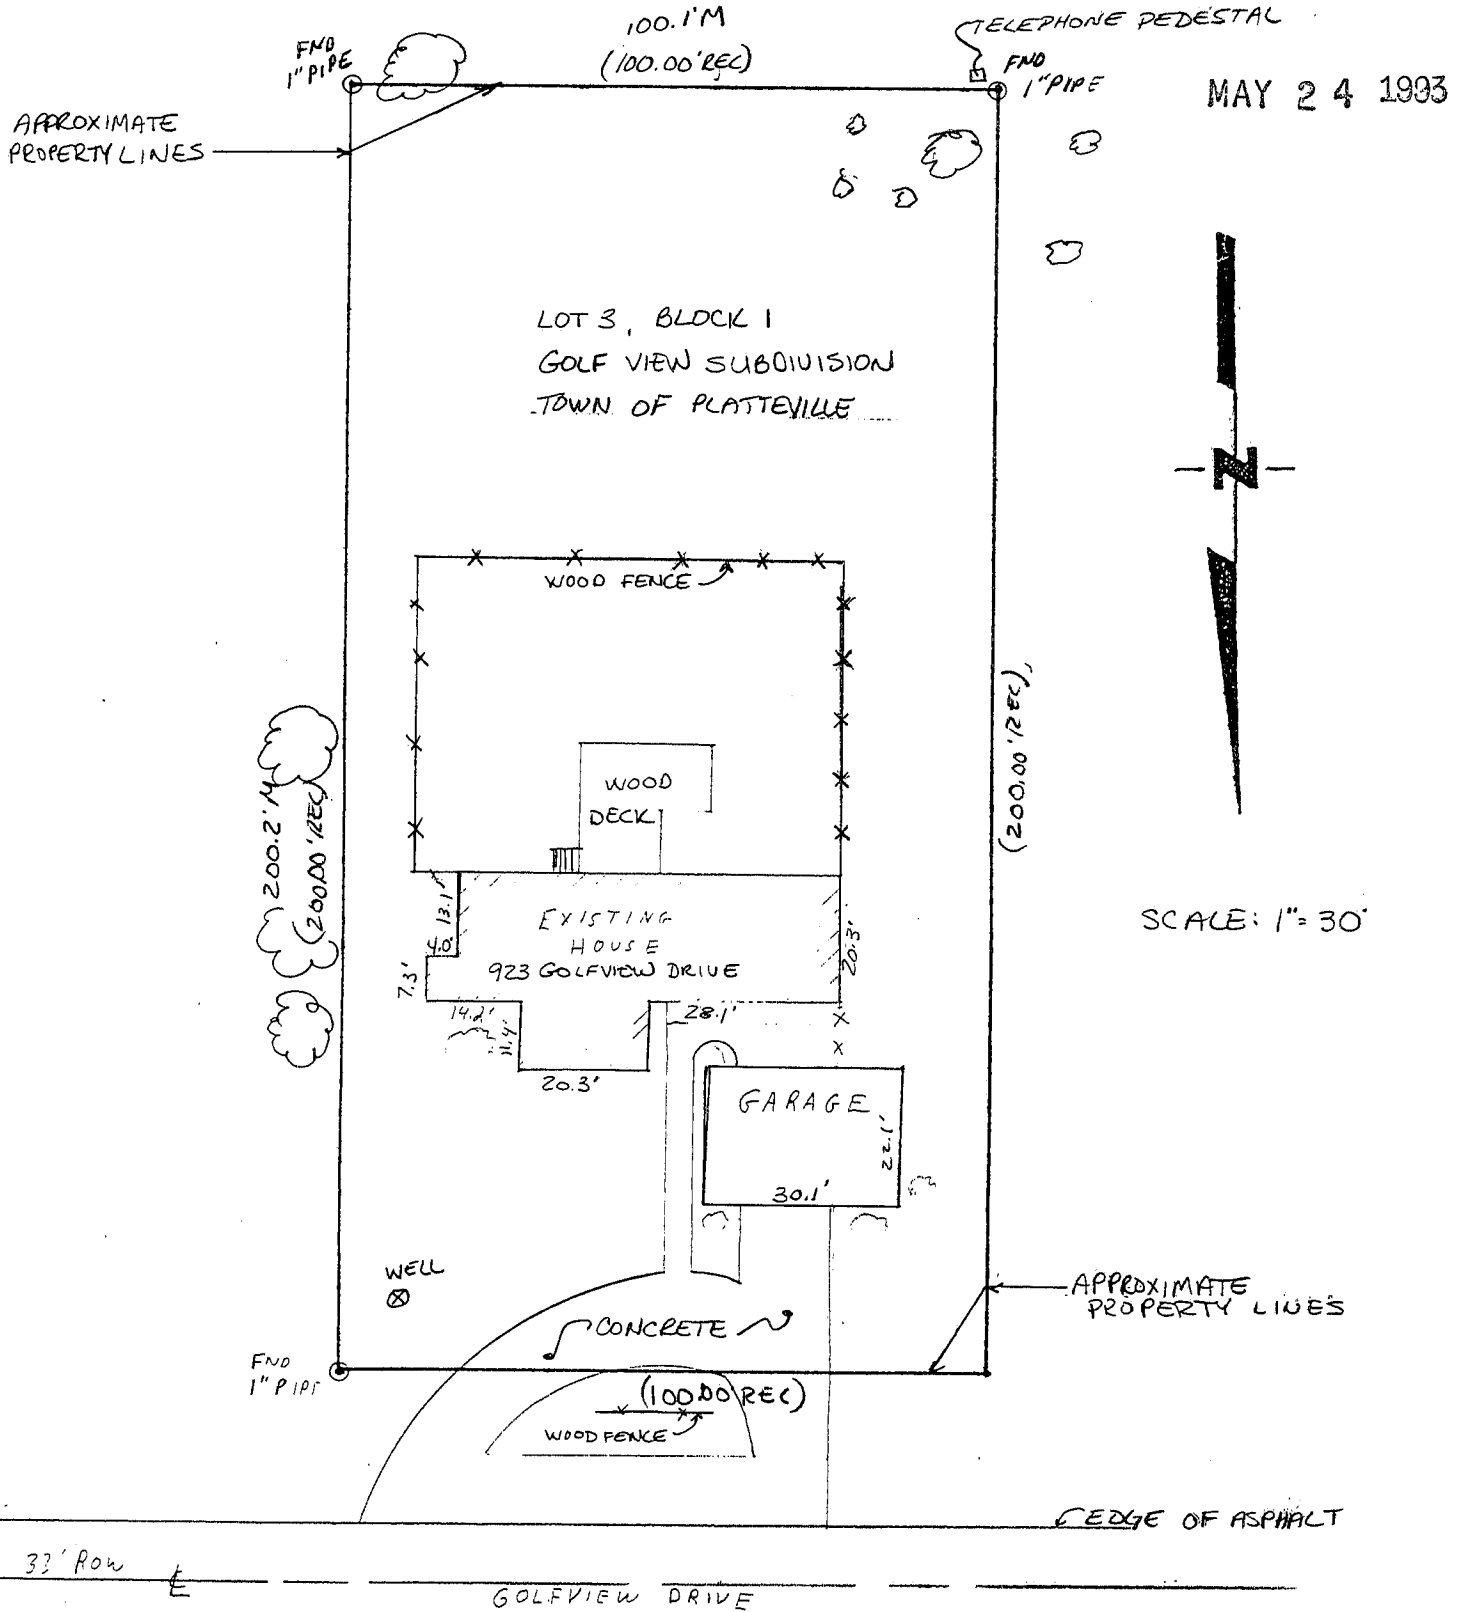

David F. Burbach
DAVID F. BURBACH
S-2019
REGISTERED LAND SURVEYOR
FEBRUARY 24, 1993

1E

LEGAL DESCRIPTION:

Lot Three (3) of Block One (1) of Golf View Subdivision, Town of Platteville, being a part of the Southeast Quarter (S.E.1/4) of the Southeast Quarter (S.E.1/4) of Section Three (3), Township Three (3) North, Range One (1) West of the 4th P.M., Grant County, Wisconsin.

SURVEYOR'S NOTE:

As clients of Burbach Municipal & Civil Engineers, I/we request that the inspection be made according to the following specifications:

- 1). Only enough work be performed to satisfy the requirements of the lending institution.
- 2). Only recorded (Deed) distances and bearings be shown.

It is specifically intended to exempt this inspection from the requirements of A-E 7.03, A-E 7.05(2), (3), and (4) and A-E 7.06 of the Wisconsin Administrative Code, and is so stated and agreed to as required by A-E 7.01(2).

David F. Burbach

Dated February 26, 1993

CERTIFICATE: I hereby certify that I have inspected the above described parcel and that the above map is a true representation thereof and shows the approximate location of the parcel, its recorded exterior boundaries, the location of all visible roadways and encroachments, if any. This inspection is made for the use of the purchasers' mortgage institution and is valid for one-half year from the date hereof. I further certify that such inspection and the representation thereof hereon are true and correct to the best of my knowledge and belief.

David F. Burbach
David F. Burbach
S-2019
Registered Land Surveyor
February 26, 1993.

