

96

GRANT COUNTY
RECEIVED

JUN 16 1993

Lot 7 & 8, Block 1, Hinmann Addition
City of Escobed

PLAT OF SURVEY FOR THE BOSCOBEL HOUSING AUTHORITY


GRANT COUNTY
RECEIVED

JUN 16 1993


1111 17 1007

LOTS 7 & 8, BLOCK 1, HINMANN ADDITION
CITY OF BOSCOBEL, GRANT CO. WI

PLAT OF SURVEY FOR THE BOSCOBEL HOUSING AUTHORITY
P. O. BOX 486 RICHLAND CENTER, WIS. 53581
CITY OF BOSCOBEL JOB NUMBER 1102B
MAY 7, 1993 SCALE: 1" = 20'

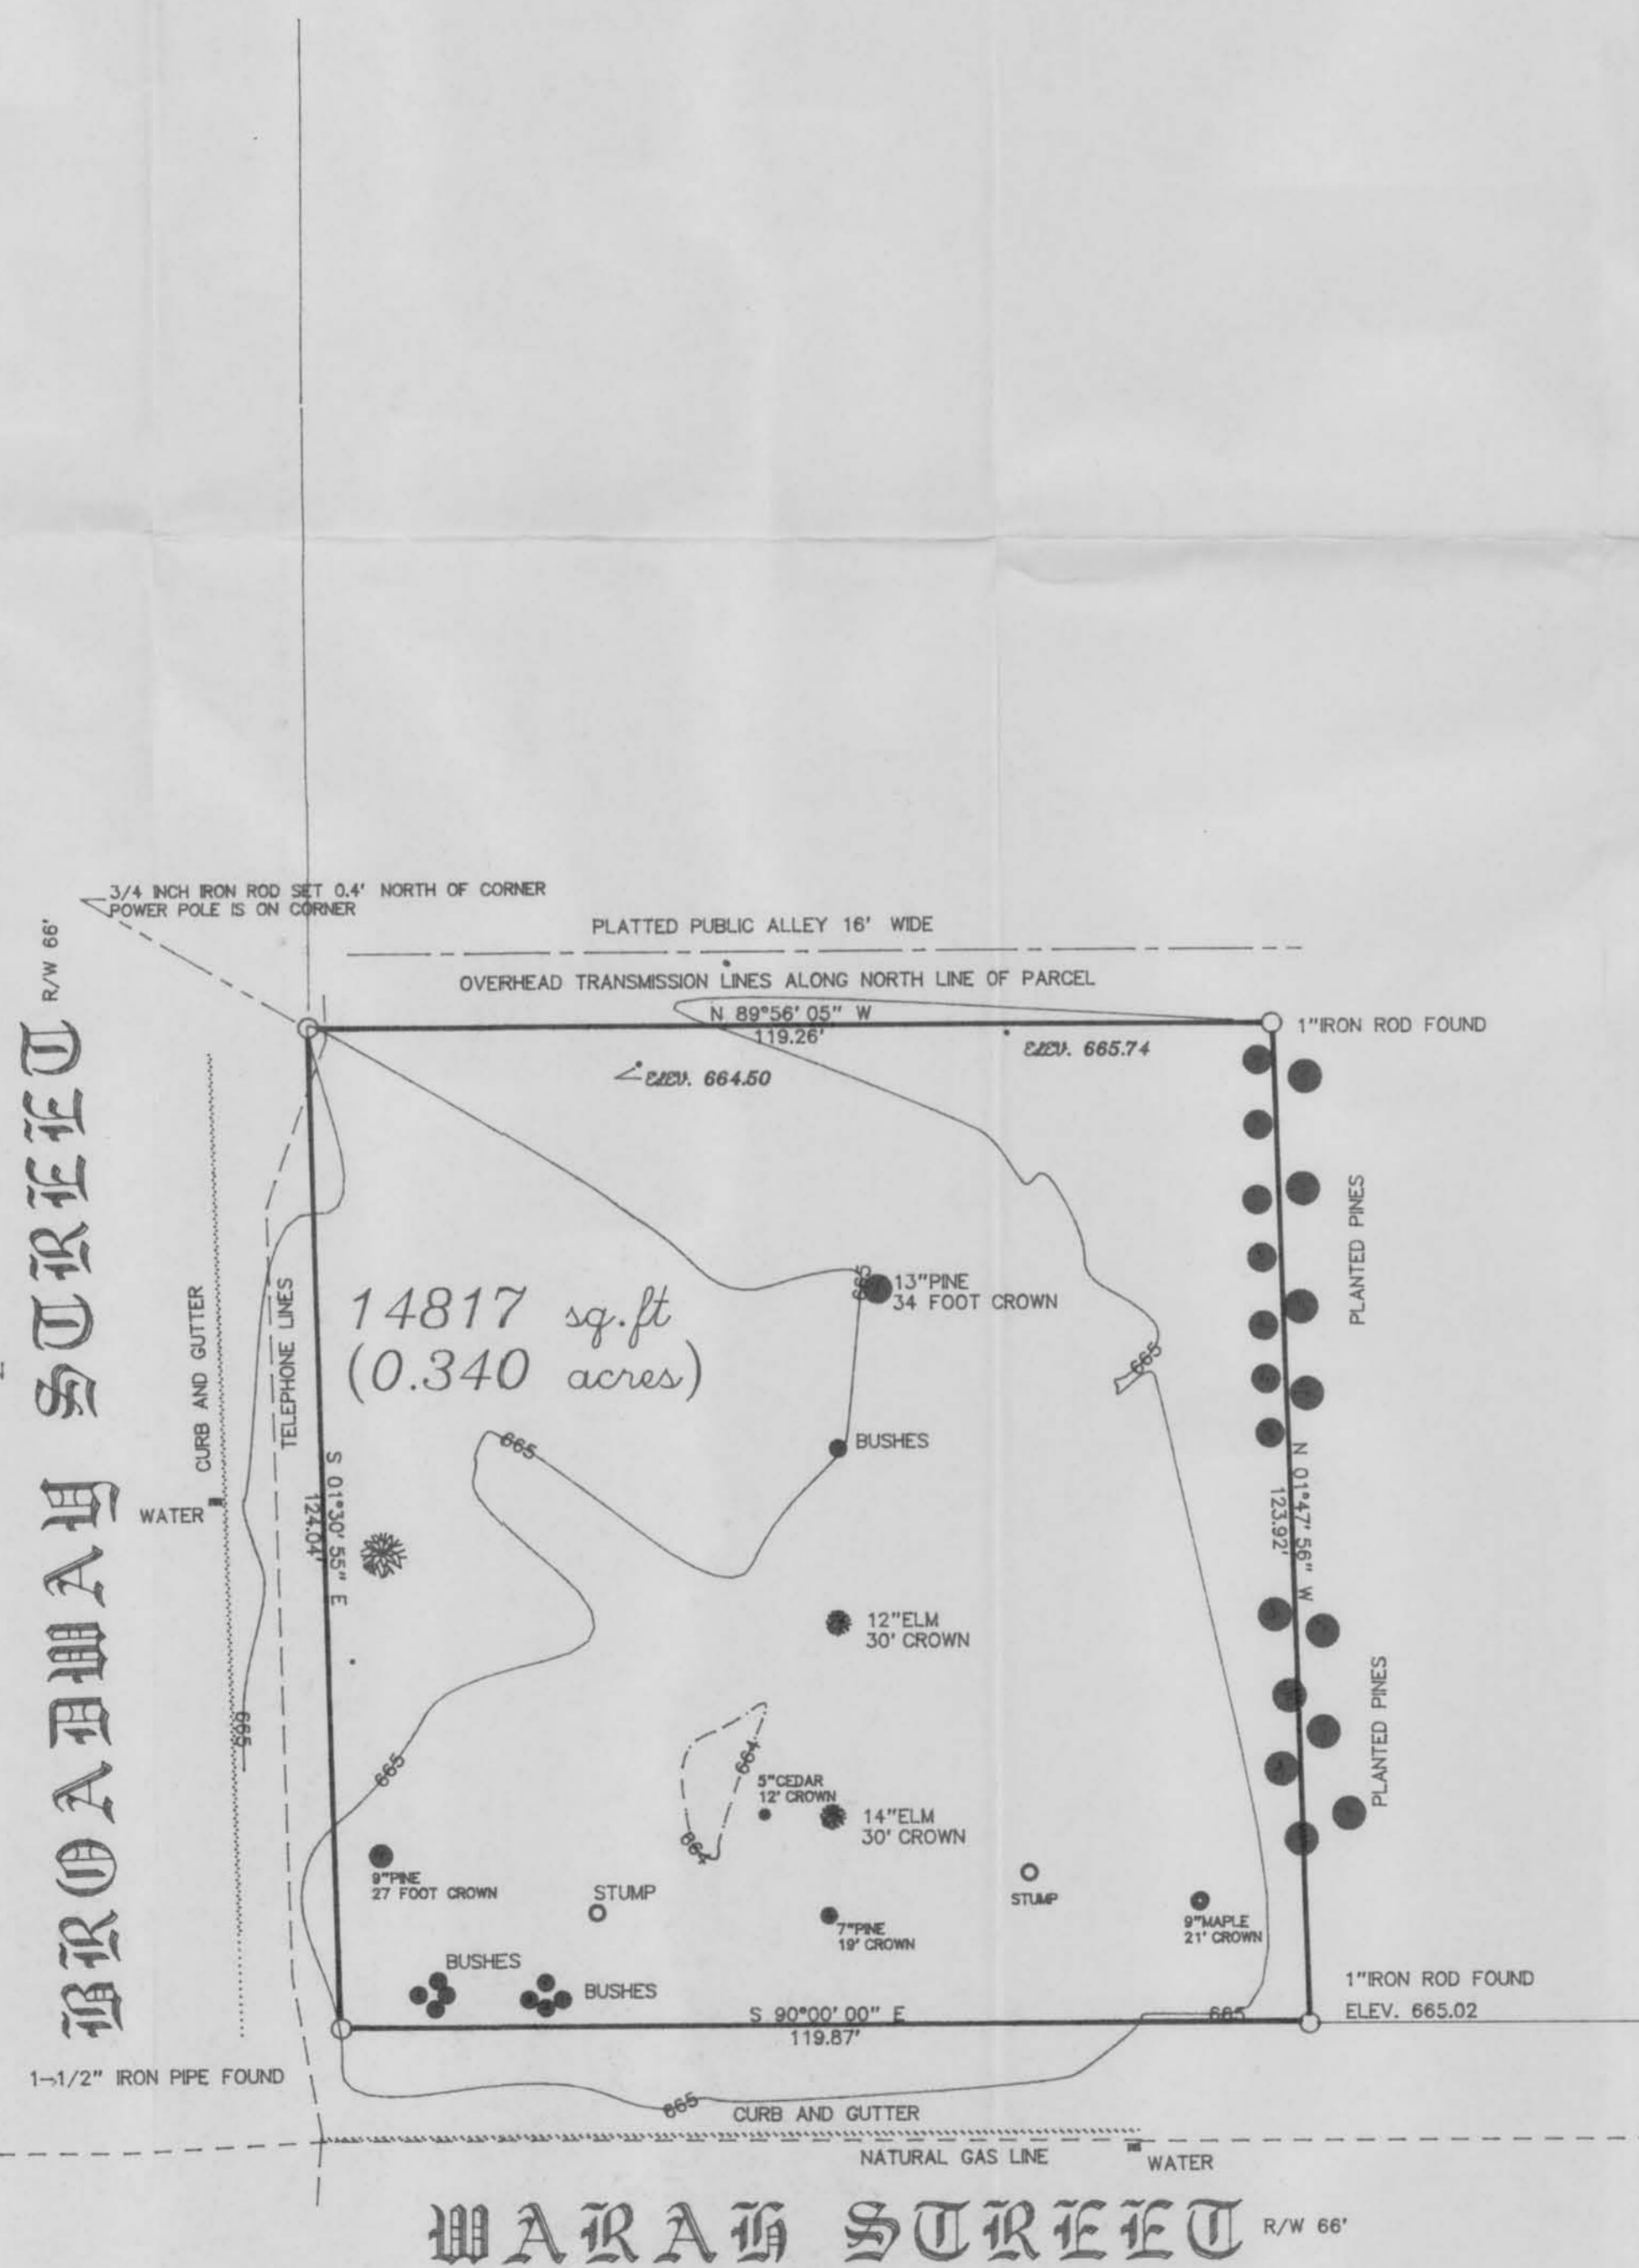

BLOCK 1, HINMANN ADDITION

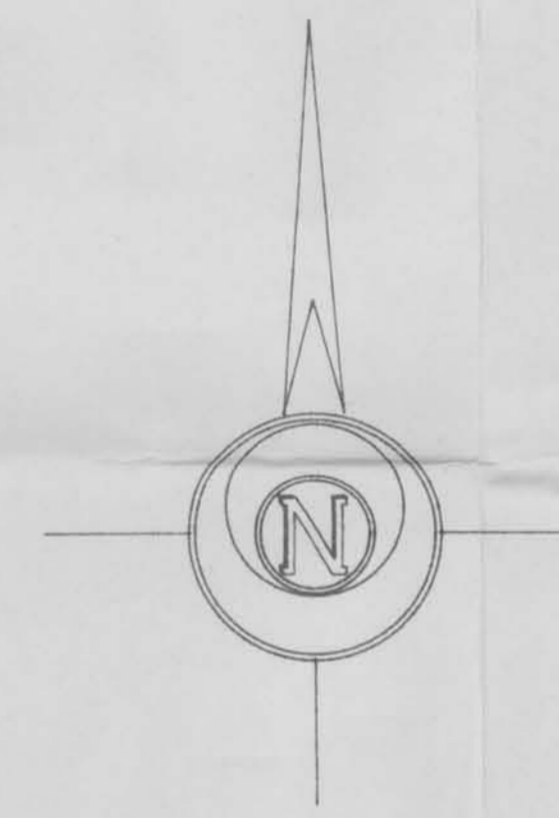

NOTE CHARACTERISTICS OF UTILITIES SHOULD BE OBTAINED FROM BOSCOBEL UTILITIES

UTILITIES

TELEPHONE
PTI COMMUNICATIONS
1125 WISCONSIN AVE.
BOSCOBEL, WI 53508

ELECTRIC, SEWER & WATER
BOSCOBEL UTILITIES
1031 WISCONSIN AVE.
BOSCOBEL, WI 53805

NOTE: LOCATIONS OF UTILITIES ARE APPROXIMATE AS LOCATED THROUGH DIGGERS HOWLINE



Sean M. Walsh
MAY 7 1993