

AUG 13 1993

## PLAT OF SURVEY for DAVID CAYHILL

previously described as :

BLOCK EIGHT (8) OF THE VILLAGE OF CASTLE ROCK, GRANT COUNTY, WISCONSIN, according to the recorded map and plat thereof; also a piece of land extending in a Northwesterly direction and adjoining Block 8, a distance of Fifty (50') feet and lying between the road and the mill race, the same being 50 feet by 55 feet in area.


I, Bruce D. Bowden, Registered Wisconsin Land Surveyor - 1250, do hereby certify that I have surveyed, monumented and mapped the property described above in accordance with the instructions of Mr. Robert Gust and Mr. David Cayhill and that this map is a correct representation thereof to the best of my knowledge and belief. Also, I am in full agreement with Abstract No. 6923 of the Midwest Title entry #21, which states there is no BLOCK 8 in the Plat of the Village of Castle Rock. Having examined the descriptions for the adjoining properties, I find the configuration shown on this survey to be the best and most reasonable match for the intent of the above description. Also, a more reasonable description for this property would be as follows:

Those parts of the Hydraulic Block and Mill Street of the Plat of the Village of Castle Rock in the Southeast 1/4 of the Southeast 1/4 of Section 30, Town 7 North, Range 1 West, Castle Rock Township, Grant County, Wisconsin, described as: Commencing at the Southeast corner of said Section 30; thence N 89°43'20" W along the South line thereof, 830.88'; thence N 0°16'40" E, 540.23' to the intersection of the East line of County Trunk Highway 'Q' and the North line of property described in Volume 658 on Page 21, being a #6X24" reinforcing rod and the point of beginning; thence Northwesterly, 126.42' along the said right-of-way, being the arc of a 442.59' radius curve to the right, making a central angle of 16°22'00" and a long chord of 125.99' that bears N 24°49'08" W to a #6x24" reinforcing rod; thence continuing on said right-of-way N 16°38'08" W, 235.87' to a #6 reinforcing rod; thence S 30°05'53" E with the Mill Race, 404.32' to a #6 reinforcing rod on the North line of the said Vol 658 and Page 21; thence N 83°27'18" W, 82.89' to the point of beginning. Containing 15940 sq.ft (0.366 acres), more or less, and being subject to any and all easements and rights-of-way of record and/or usage.

NOTE : Bearings are referenced to the South line of the Southeast 1/4 of Section 30, which is recorded as bearing N 89°43'20" W.

LEGEND

- Existing #6 reinforcing rod
- Existing #8 reinforcing rod
- ⊕ Existing Aluminum Monument
- #6-x-24" reinforcing rod
- ( ) Recorded As

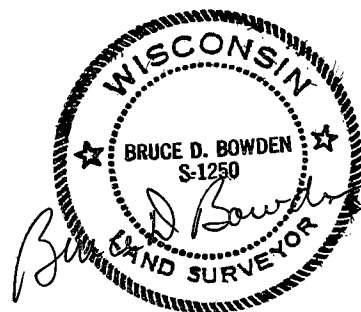

NOTE : Original Plat of the Village of Castle Rock, 1895 Atlas and Highway Plans are shown from scaled map overlays.

August 12, 1993

BOWDEN SURVEYING  
619 West Merrimac St.  
Dodgeville, Wi. 53533  
Phone(608) 935 - 5513