


# MORTGAGE SURVEY

NOV 15 1993

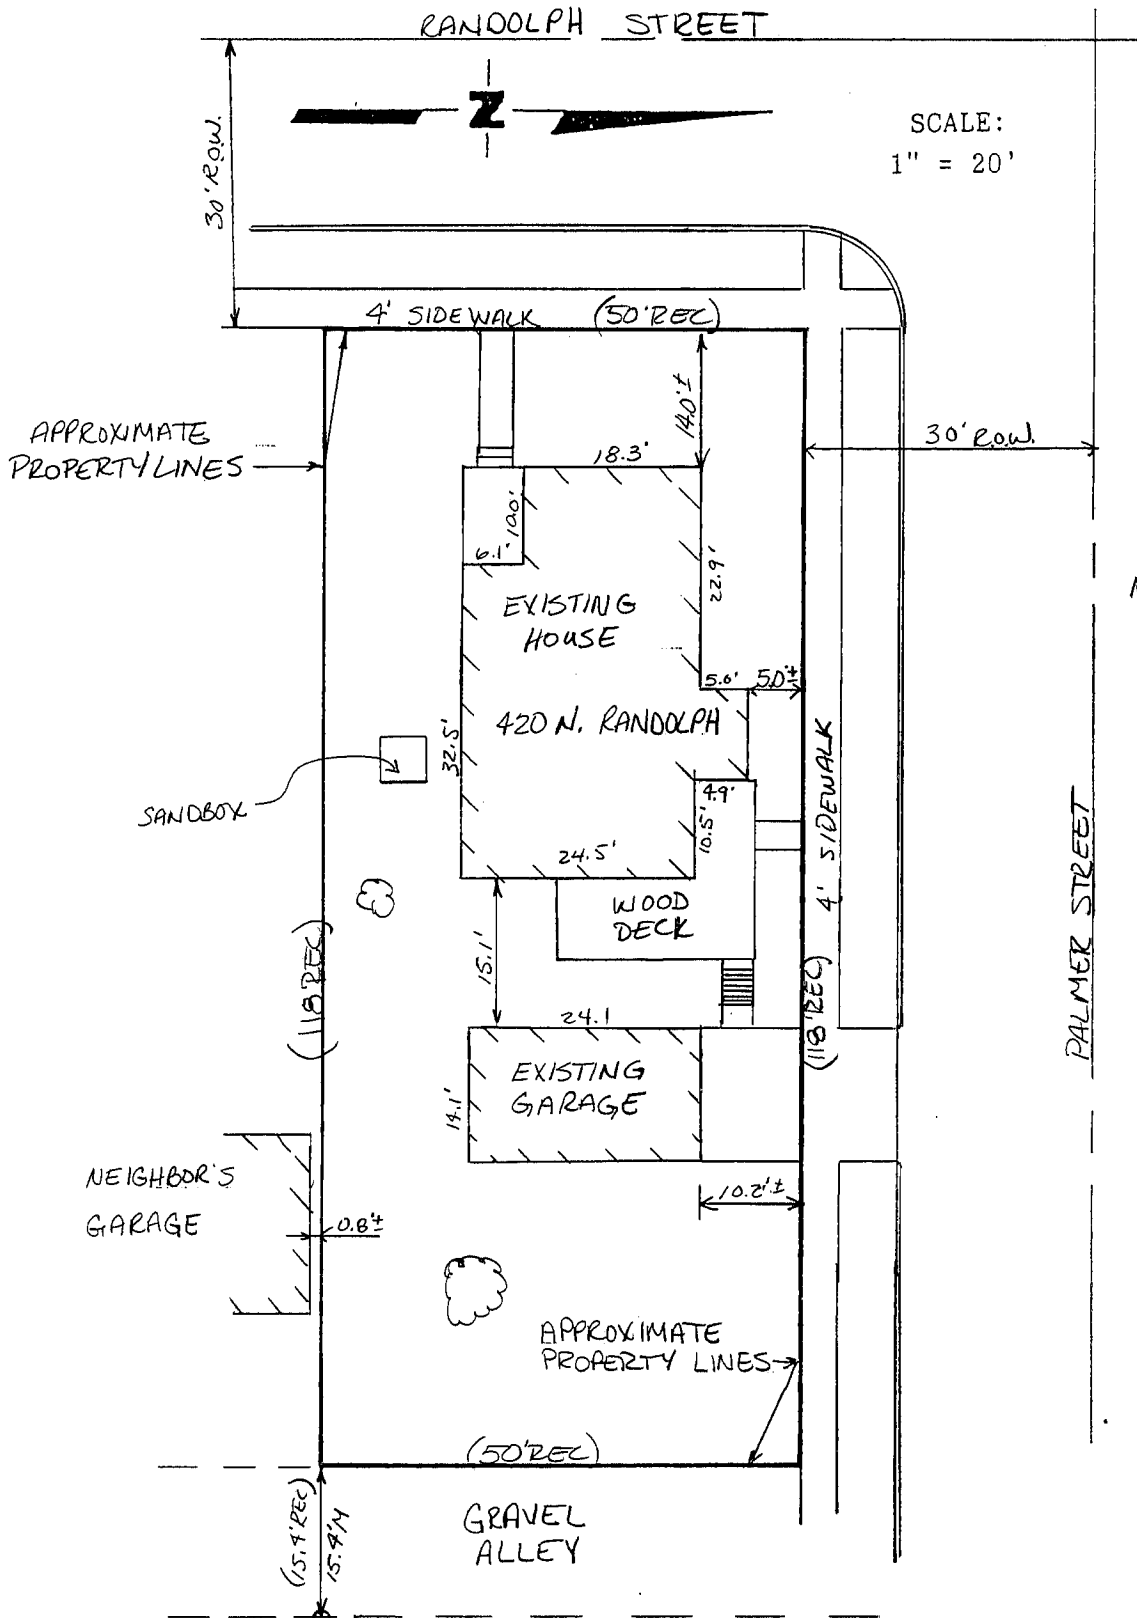

SURVEYOR'S NOTE:  
NO PROPERTY IRONS WERE FOUND. LAND SURVEY IS NEEDED TO ESTABLISH ACTUAL PROPERTY CORNERS.

David F. Burbach

DAVID F. BURBACH  
S-2019  
REGISTERED LAND SURVEYOR  
SEPTEMBER 2, 1993



LEGAL DESCRIPTION:


Lot One (1) in Block Three (3) of Cuba City Improvement Company's Second Addition to the Village of Cuba City, Grant County, Wisconsin, according to the recorded plat thereof.

SURVEYOR'S NOTE:

As clients of Burbach Municipal & Civil Engineers, I/we request that the inspection be made according to the following specifications:


- 1). Only enough work be performed to satisfy the requirements of the lending institution.
- 2). Only recorded (Deed) distances and bearings be shown.

It is specifically intended to exempt this inspection from the requirements of A-E 7.03, A-E 7.05(2), (3), and (4) and A-E 7.06 of the Wisconsin Administrative Code, and is so stated and agreed to as required by A-E 7.01(2).

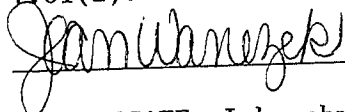

Dated September 2, 1993

CERTIFICATE: I hereby certify that I have inspected the above described parcel and that the above map is a true representation thereof and shows the approximate location of the parcel, its recorded exterior boundaries, the location of all visible roadways and encroachments, if any. This inspection is made for the use of the purchasers' mortgage institution and is valid for one-half year from the date hereof. I further certify that such inspection and the representation thereof hereon are true and correct to the best of my knowledge and belief.

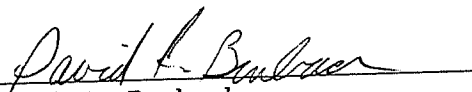  
David F. Burbach  
S-2019  
Registered Land Surveyor  
September 2, 1993



**BURBACH MUNICIPAL & CIVIL ENGINEERS**