


**LEGEND**

●	Iron Stake found
○	Valve
⊕	Hydrant
○	Pole
—S—	Sanitary Sewer line
—W—	Water main
—G—	Gas line
—Eo—	Overhead Electric line
—Eu—	Underground Electric line
x199.70	Spot Elevation
[Hatched Box]	Building
[Dotted Box]	Concrete

**DESCRIPTION:**  
 Lot 1, except the west 22 feet 9 inches, in Block 142, of the Original Plat of the Village of Muscoda, Grant County, Wisconsin.

- NOTES:**
- 1 BENCH MARK is the top of the Hydrant Elevation 202.60
  - 2 Sewer and water information is from the Village of Muscoda.
  - 3 All elevations are Village of Muscoda datum.
  - 4 Gas information is from Wisconsin Gas Co.

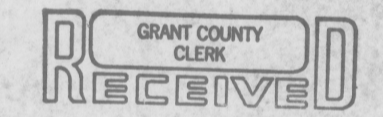


MAY 3 1993

GTE North, Inc.  
 100 Communications Drive  
 Sun Prairie, Wisconsin 53093

I hereby certify that I have surveyed the property described above according to the description furnished and located the improvements as shown and that this map is a correct representation thereof.

Madison, Wisconsin *Donald L. Paulson*  
 Donald L. Paulson  
 Land Surveyor #S-728

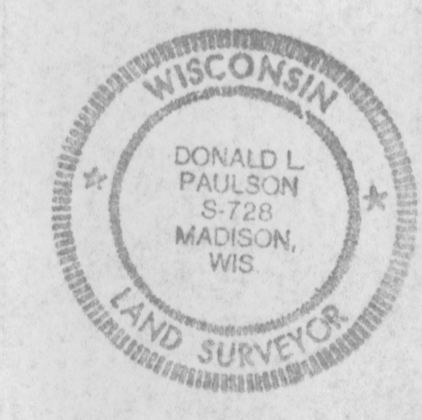

ARNOLD AND O'SHERIDAN, INC.  
 CONSULTING ENGINEERS  
 615 FORWARD DRIVE MADISON, WISCONSIN 53706-2711-9851  
 LOT 1, EXCEPT THE WEST 22'-9", BLOCK 142,  
 ORIGINAL PLAT OF THE VILLAGE OF MUSCODA,  
 GRANT COUNTY, WISCONSIN

DR. FRT CKD. DATE 4/28/93 JOB NO. 93140-C  
 DATE PRINTED 4/30/93