
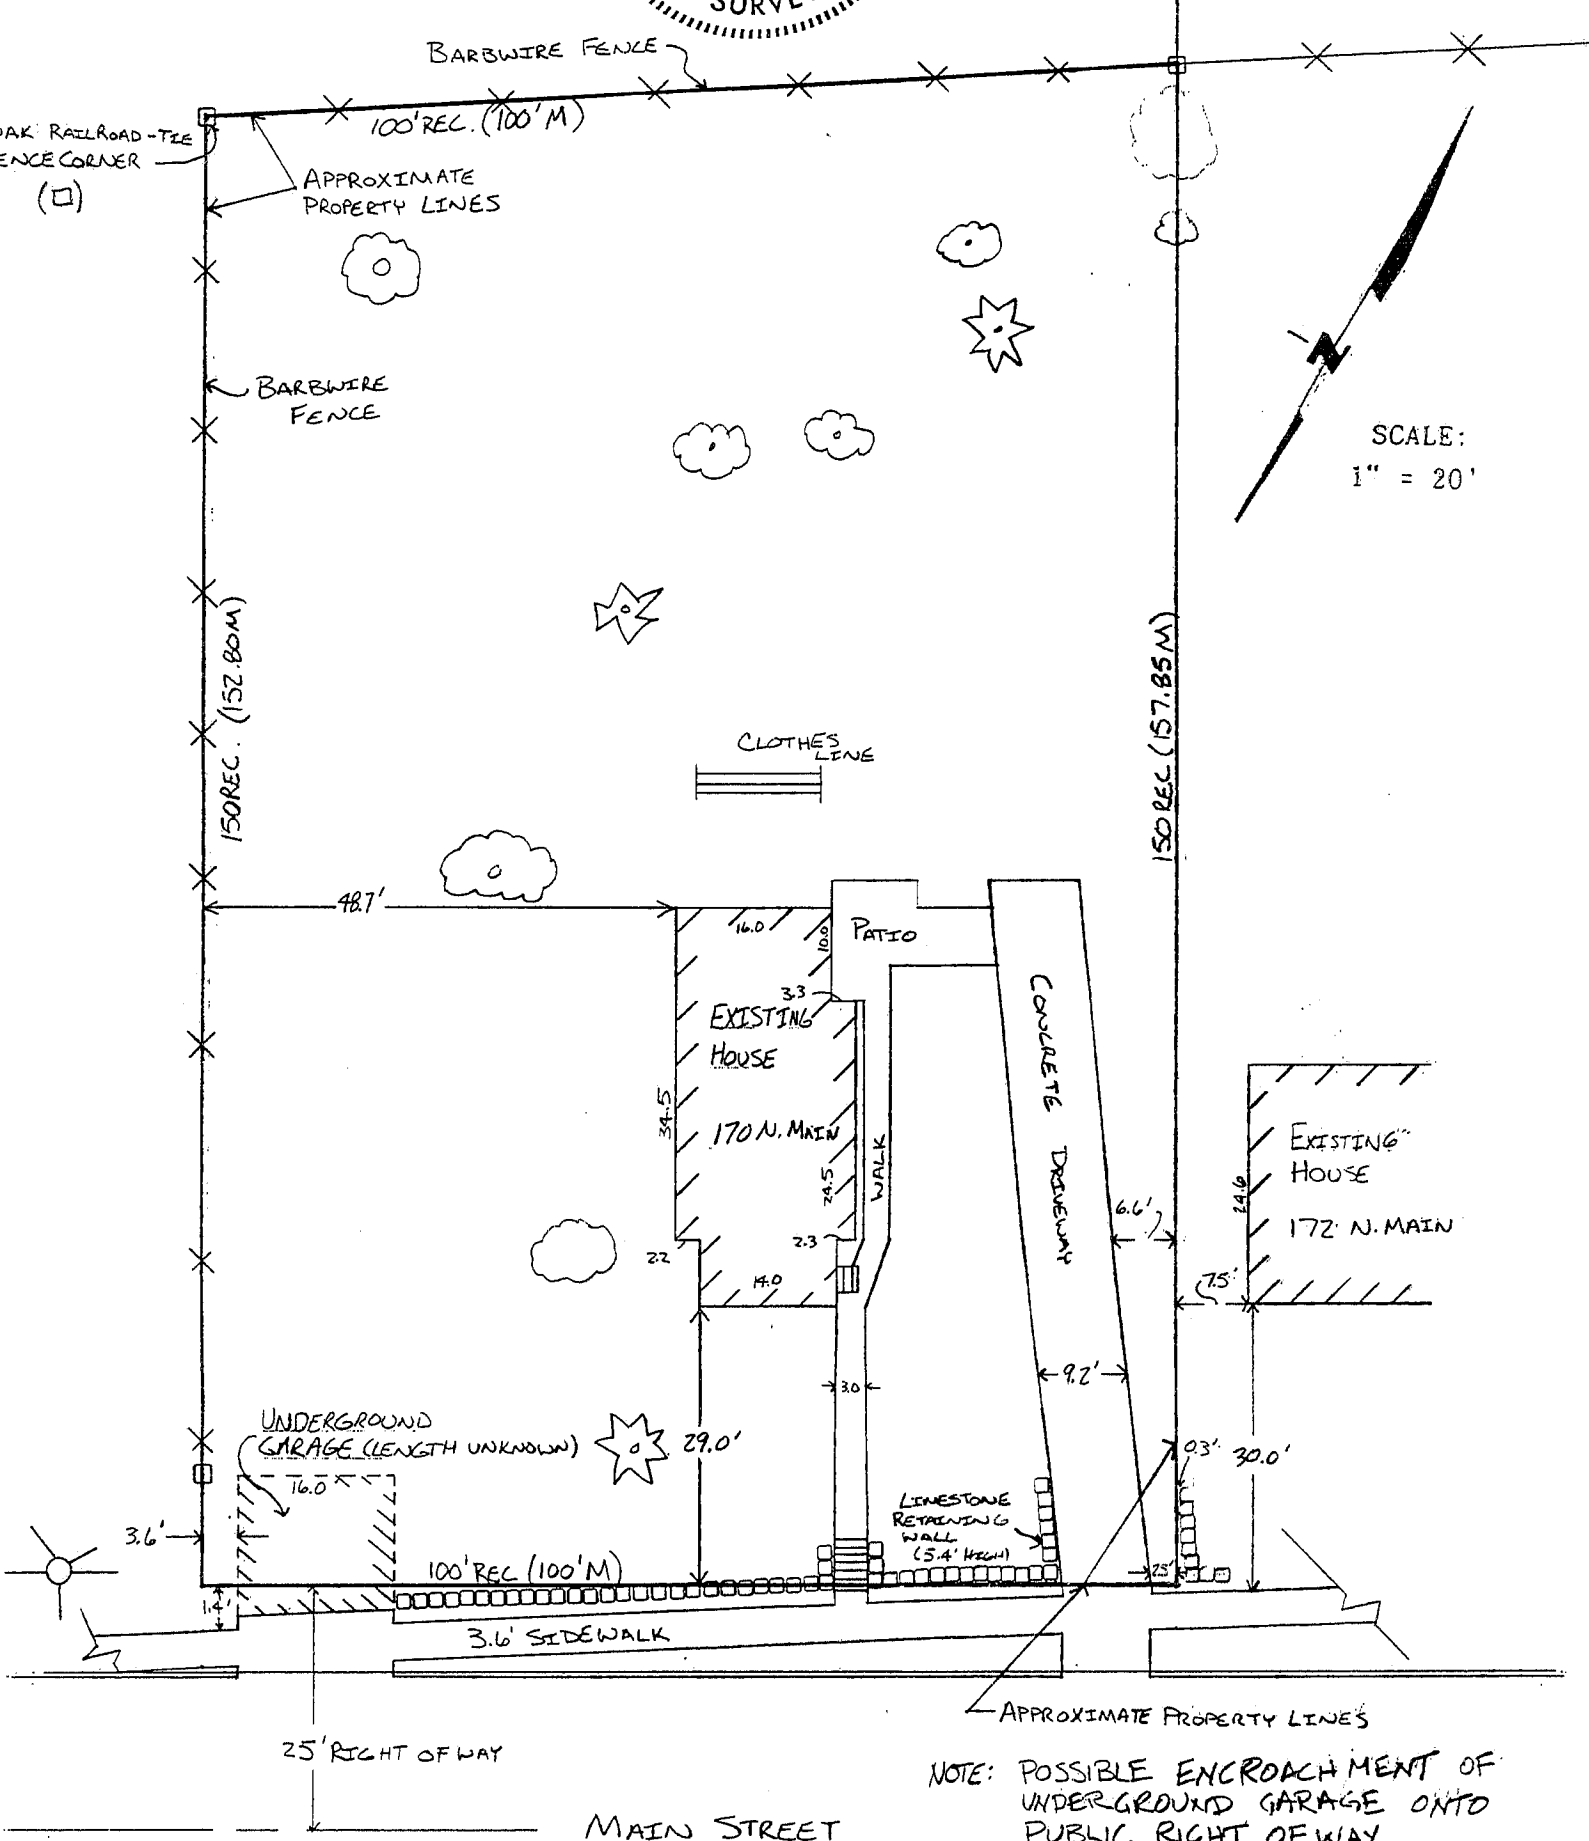


MORTGAGE SURVEY

5

NOV 15 1993

David F. Burbach
DAVID F. BURBACH
S-2019
REGISTERED LAND SURVEYOR
OCTOBER 22, 1993

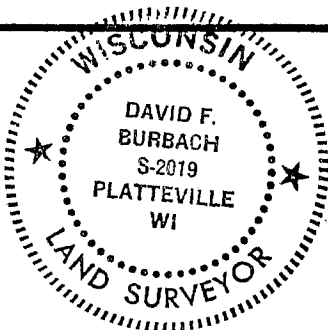

SCALE:
1" = 20'

NOTE: POSSIBLE ENCRoACHMENT OF UNDERGROUND GARAGE ONTO PUBLIC RIGHT OF WAY.
NOTE: RECOMMEND FULL LAND SURVEY FOR THIS PARCEL.

BURBACH MUNICIPAL & CIVIL ENGINEERS

LEGAL DESCRIPTION:

All that part of Out-lot 35 described as follows: Commencing at the Southeast corner of Out-lot 35, running thence along the line between Out-lot 35 and 34 150 feet, thence West parallel with the public highway 100 feet, thence South parallel with the East line of said Lot 35 150 feet to the public highway, thence East along the public highway 100 feet to the place of beginning, said tract of land being 100 feet front and 150 feet in depth. All being in the Village of Potosi, in the Subdivision of Section 34, Town Three (3) North, Range Three (3) West of the 4th P.M., Grant County, WI.

SURVEYOR'S NOTE:

As clients of Burbach Municipal & Civil Engineers, I/we request that the inspection be made according to the following specifications:

1). Only enough work be performed to satisfy the requirements of the lending institution.

2). Only recorded (Deed) distances and bearings be shown.

It is specifically intended to exempt this inspection from the requirements of A-E 7.03, A-E 7.05(2), (3), and (4) and A-E 7.06 of the Wisconsin Administrative Code, and is so stated and agreed to as required by A-E 7.01(2).

X Lu Ann Fecht

Dated October 14, 1993

CERTIFICATE: I hereby certify that I have inspected the above described parcel and that the above map is a true representation thereof and shows the approximate location of the parcel, its recorded exterior boundaries, the location of all visible roadways and encroachments, if any. This inspection is made for the use of the purchasers' mortgage institution and is valid for one-half year from the date hereof. I further certify that such inspection and the representation thereof hereon are true and correct to the best of my knowledge and belief.

David F. Burbach
David F. Burbach
S-2019
Registered Land Surveyor
October 14, 1993



BURBACH MUNICIPAL & CIVIL ENGINEERS