


99

GRANT

COUNTY SECTION SURVEY DATA

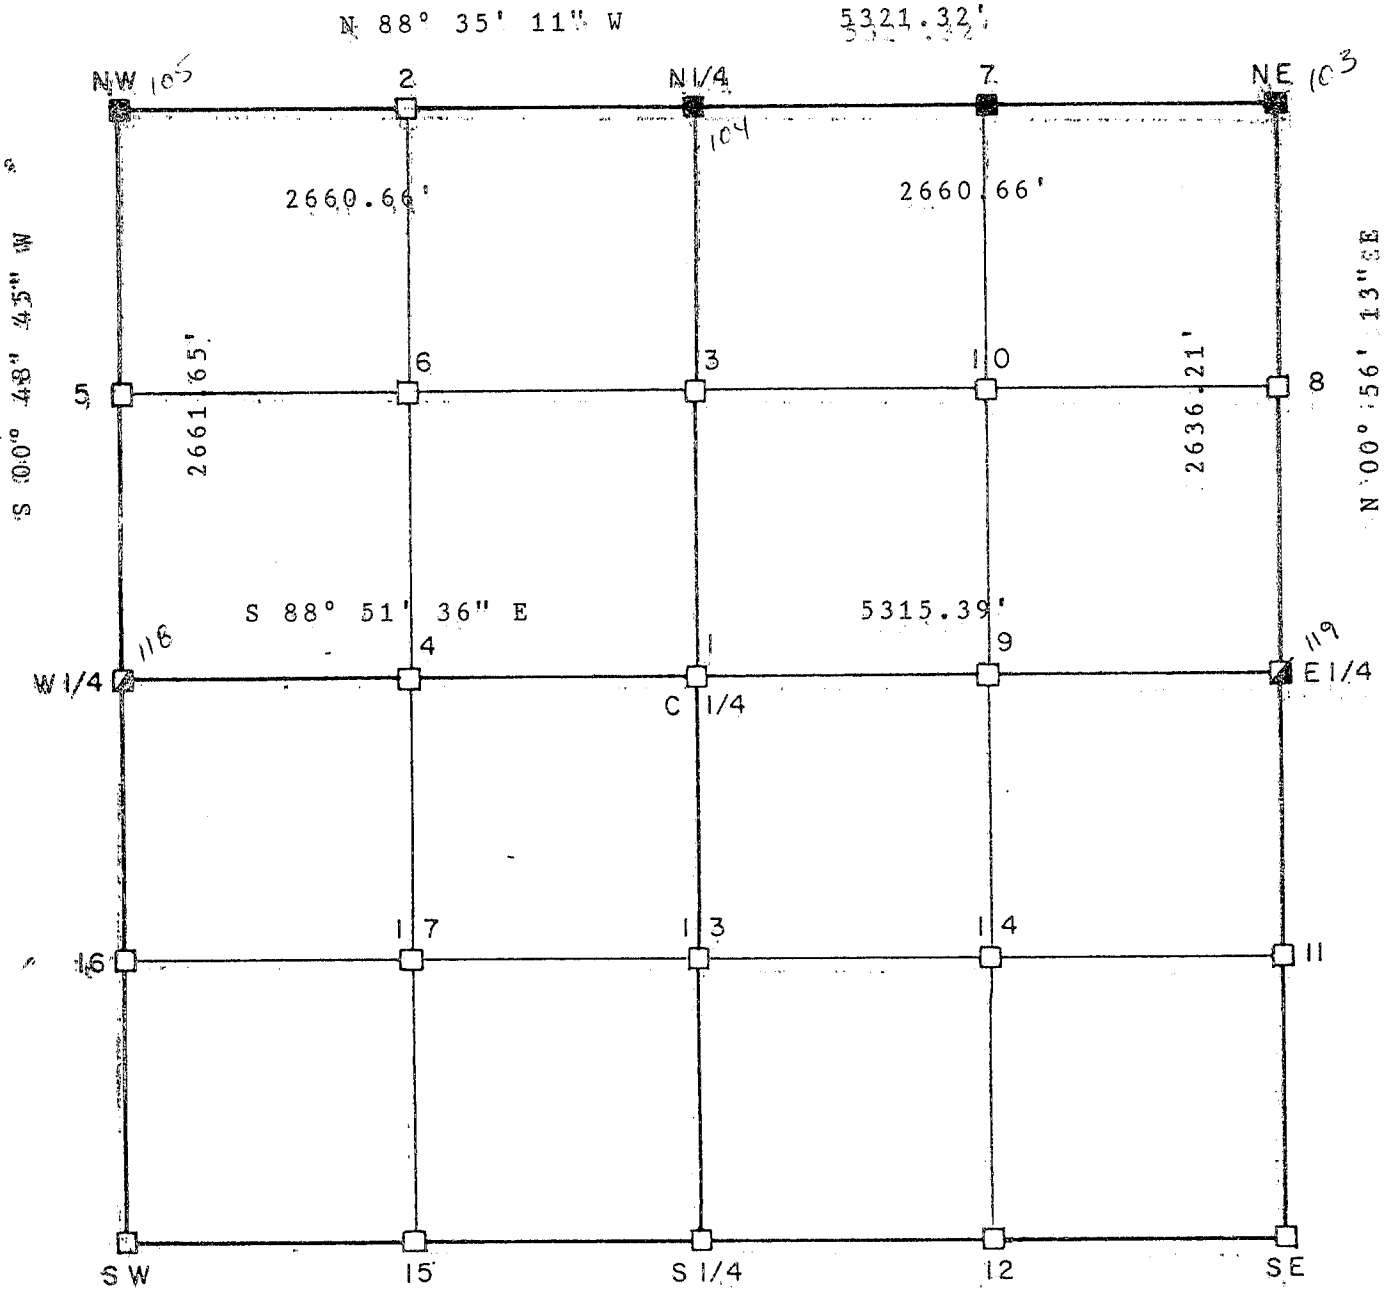

■ CORNERS RESTORED

Bearing system used: Assumed

Town 6 North, Range 5 West


Section 35

Surveyed by: Ronald R. Hayden

Date: 12/8/1987

Notes: Corner Found

SURVEYORS SEAL & SIGNATURE

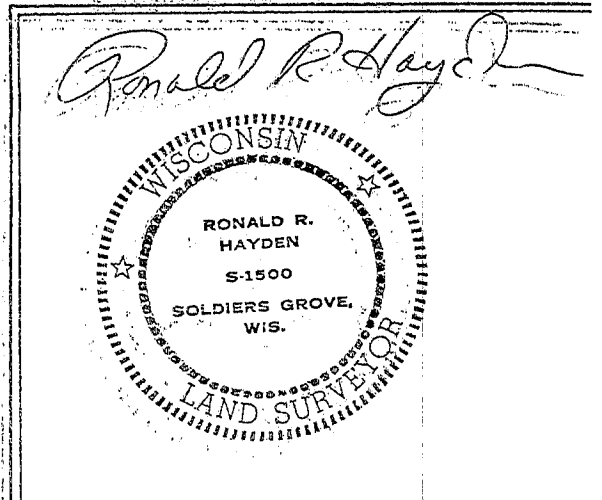

Page No. _____