


100

GRANT

COUNTY SECTION SURVEY DATA

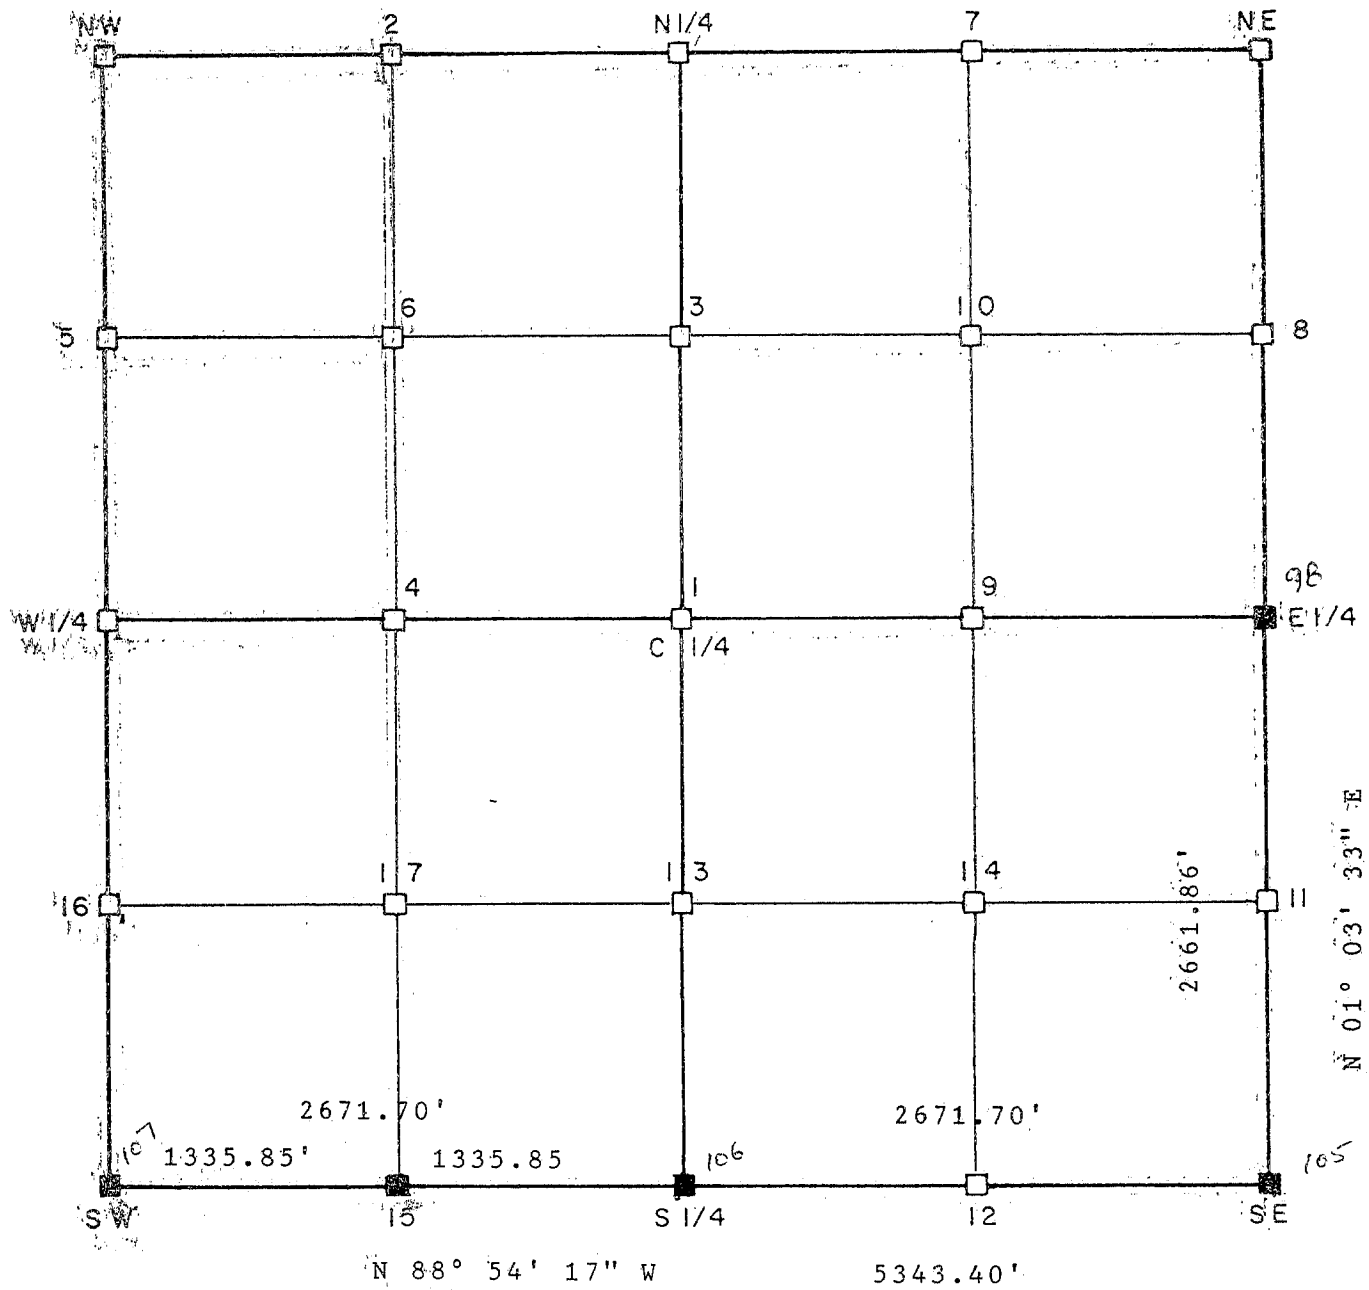

■ CORNERS RESTORED

Beating system used: Assumed

Town 6 North, Range 5 West

Section 27

Surveyed by: Ronald R. Hayden

Date: 12/8/1987

Notes:

SURVEYORS SEAL & SIGNATURE

*Ronald R. Hayden*

