



PLAT OF SURVEY FOR  
VIRGIL CHANDLER  
JOB #94S-47  
SHEET 2 OF 2

DESCRIPTION

A parcel of land located in the NW 1/4 of Section 14, T3N, R1W, City of Platteville, Grant County, Wisconsin, more particularly described as follows:

Beginning at a point located N89°06'44"E, 1,337.95' from the West 1/4 corner of said Section 14; thence N0°53'16"W, 234.96'; thence N50°20'18"E, 181.50'; thence S35°43'01"E, 49.50'; thence N67°20'18"E, 473.88'; thence N89°06'44"E, 307.56'; thence S0°53'16"E, 483.78'; thence S89°06'44"W, 917.40' to the POINT OF BEGINNING. Parcel contains 8.58 acres, more or less, and is subject to an easement for Mineral Street along the Southerly side thereof, and any other easements of record and/or usage.

SURVEYOR'S CERTIFICATE:

I hereby certify that I have made a survey according to the description and/or instructions furnished me and that the plat drawn hereon is a correct representation of that survey to the best of my knowledge and belief.


*Laurence E. Schmit*

Laurence E. Schmit RLS # S-1312

*6-7-94*

Date:

94S-47.DES  
94-1 WP-PZ

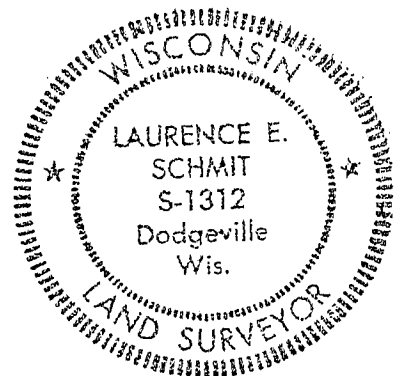

119