

SURVEY PLAT REC'D JUL 5 1994

-DAVE KLAR

6

OF THE RE-ESTABLISHMENT OF THE SE CORNER OF A PARCEL OF LAND LOCATED IN THE SE 1/4 OF THE SE 1/4 OF SECTION 29, T 3 N, R 1 W OF THE 4TH P.M., GRANT COUNTY, WISCONSIN.

SURVEYOR'S CERTIFICATE: I, LARRY L. AUSTIN, REGISTERED WISCONSIN LAND SURVEYOR, DO HEREBY CERTIFY THAT THIS SURVEY AND PLAT WERE PREPARED BY ME OR UNDER MY DIRECT SUPERVISION, ALL IN ACCORDANCE WITH THE INSTRUCTIONS OF DAVE KLAR, AND TO THE BEST OF MY KNOWLEDGE AND BELIEF, THIS PLAT IS AN ACCURATE REPRESENTATION THEREOF.


Larry L. Austin
 LARRY L. AUSTIN RLS 1903
 LARRY AUSTIN ENGINEERING
 RT. 2

2/7/94
 DATE

LANCASTER, WI 53813
 PHONE (608) 723-6363

BEARING REFERENCE: FOR PURPOSES OF THIS SURVEY BEARING ARE REFERENCED TO THE EAST LINE OF THE SE 1/4 OF SECTION 29 WHICH IS ASSUMED TO BEAR N 00° 23' 37" W.

* RETRACEMENT SURVEY TO LOCATE LOST CORNER OF 1982 SURVEY BY HALVERSON

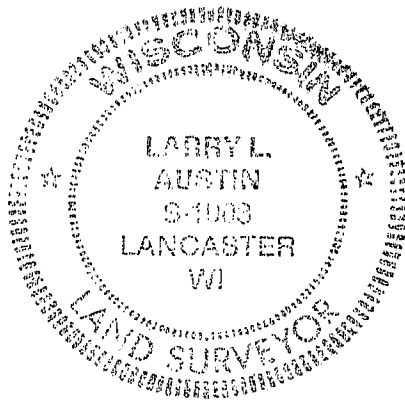

SCALE 1" = 100'



LEGEND

- ▲ RAILROAD SPIKE SET
- △ RAILROAD SPIKE END
- 1" IRON PIPE END
- 2" IRON PIPE END
- () REC. DIMEN. OR BEG.

NOTE: THIS SURVEY PERFORMED TO LOCATE THE NORTHMOST CORNER OF A TRIANGULAR PARCEL, ALSO BEING SE COR. OF 0.79 AC. PARCEL SURVEYED BY HALVERSON IN 1982

