

Date: Aug. 1, 1994

Charles James  
Village President


Diana Margis  
Village Clerk

SCALE 1" = 50'

# PLAT OF SURVEY


AUG 3 1994

44

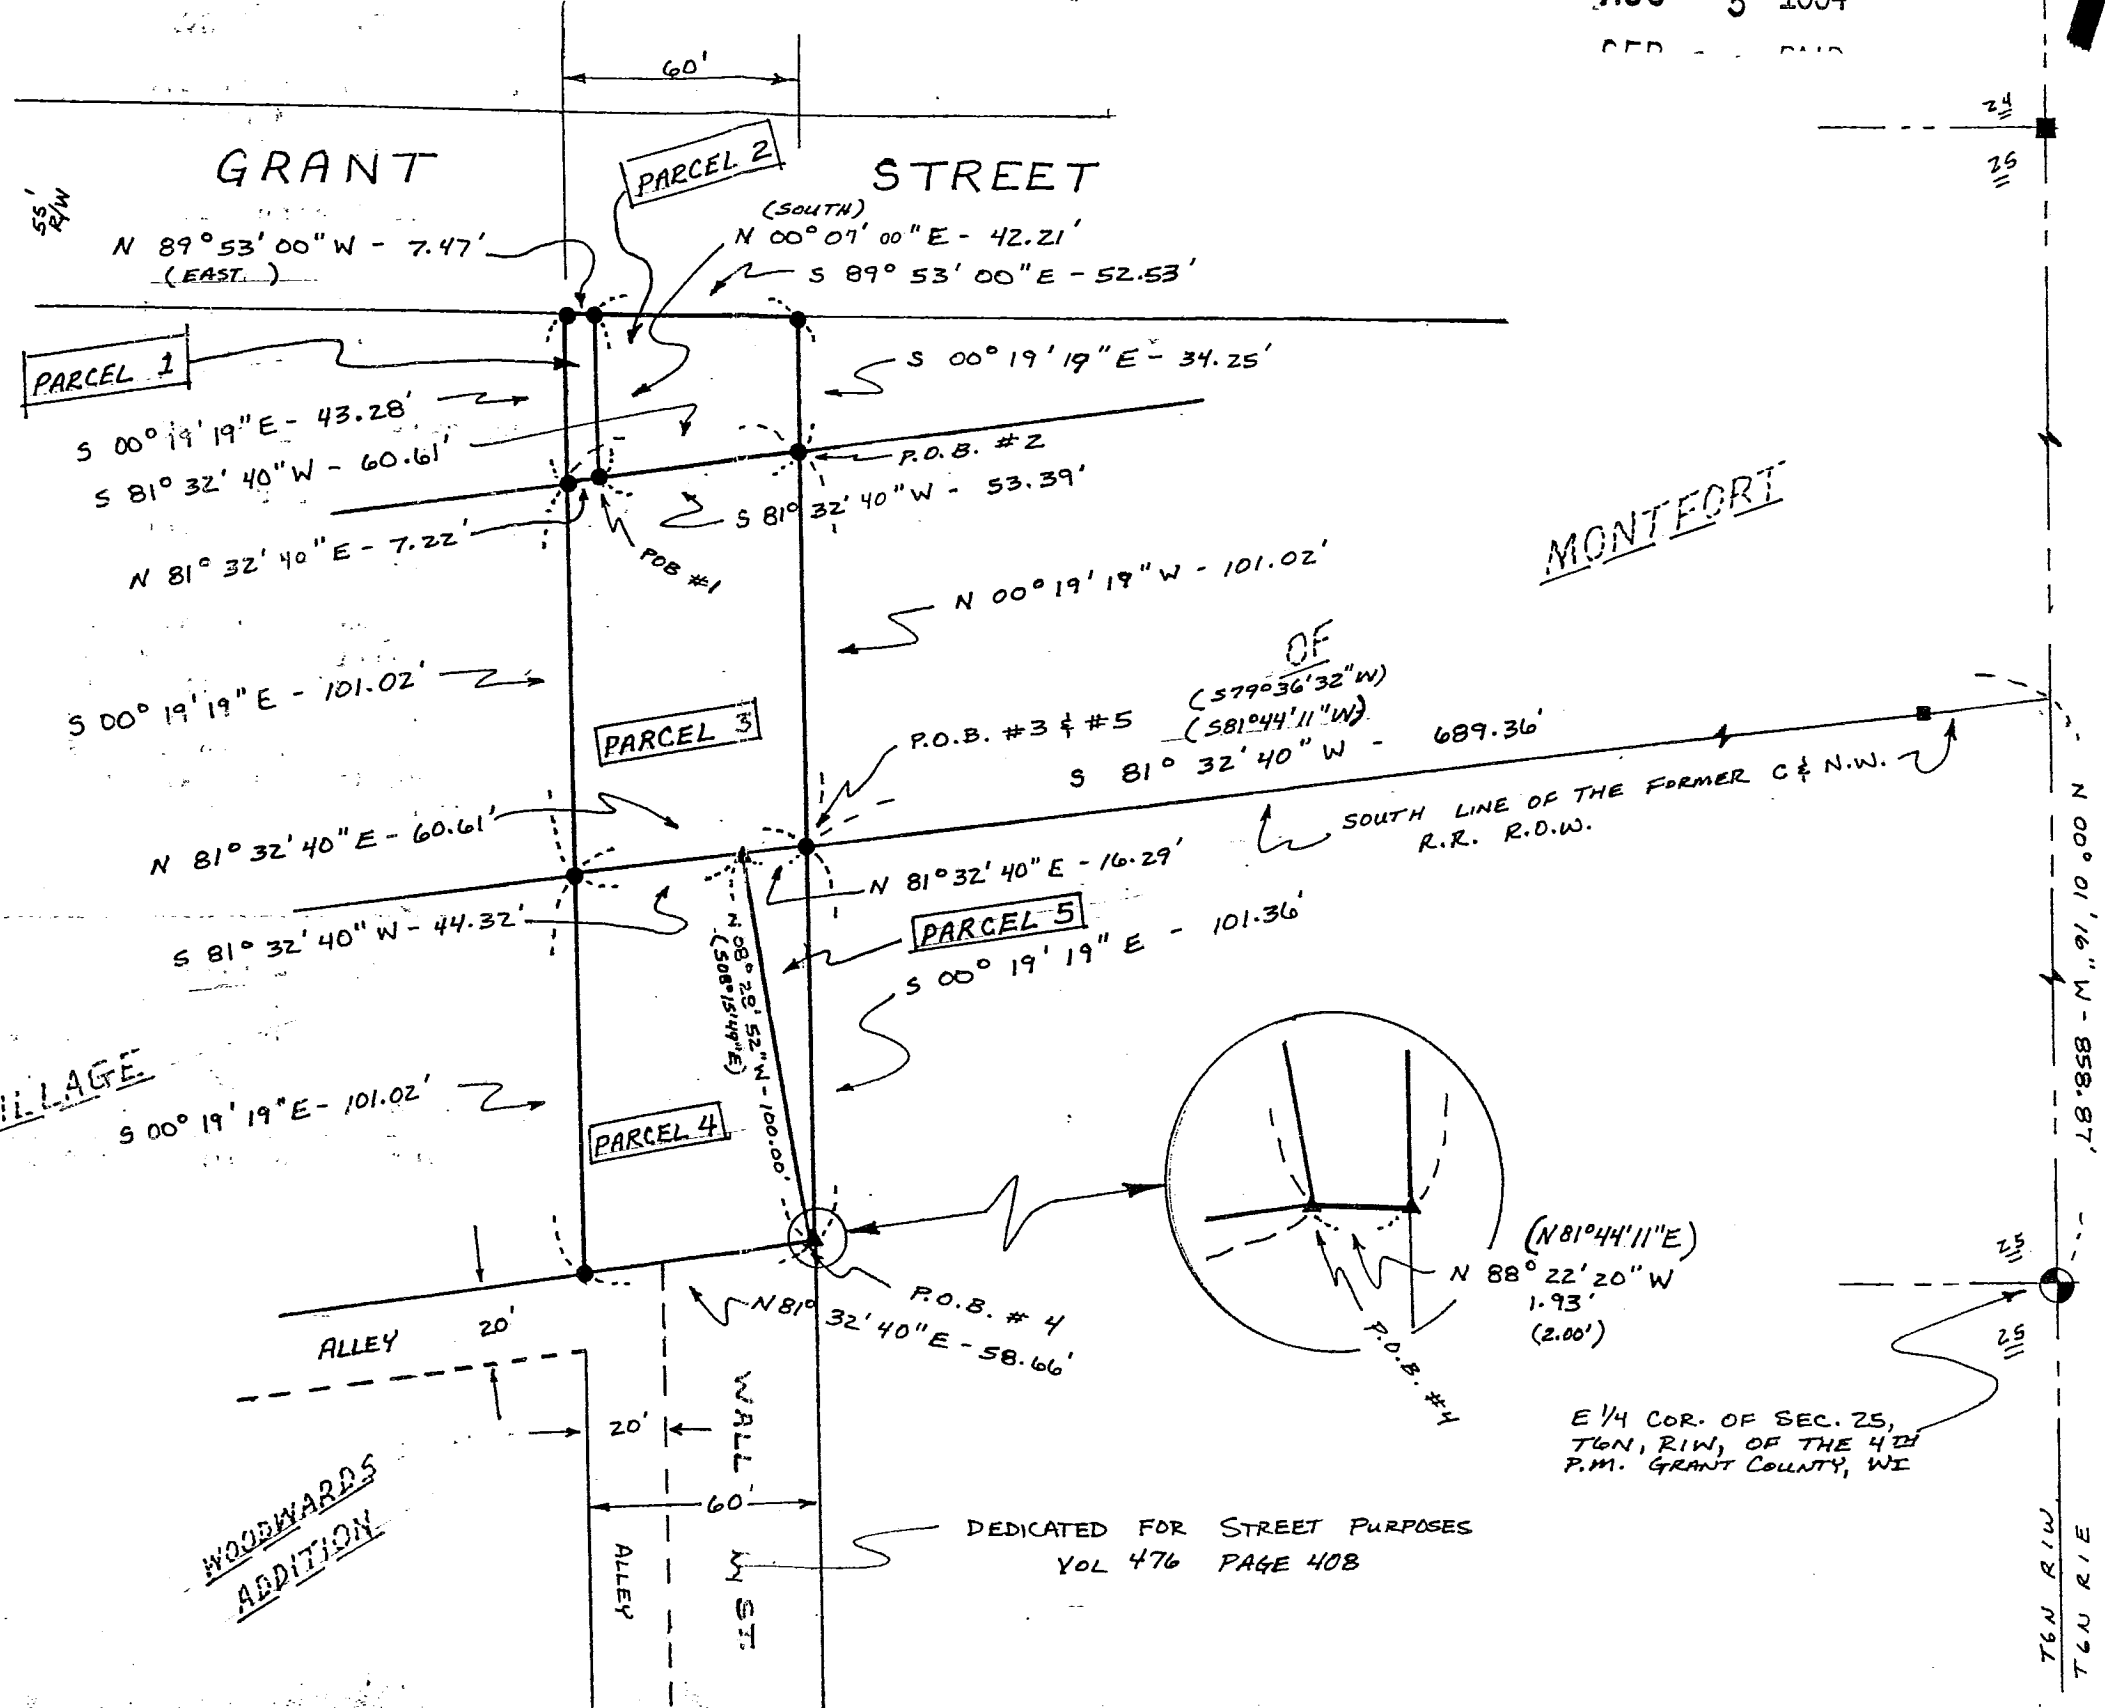

### LEGEND

- 1" X 24" IRON PIPE SET
- ▲ 1/4" REBAR FOUND
- FOUND 3/4" BAR
- ⊙ ALUMINUM D.O.T. MONUMENT FD.
- ( ) RECORDED DIM. OR BRG.

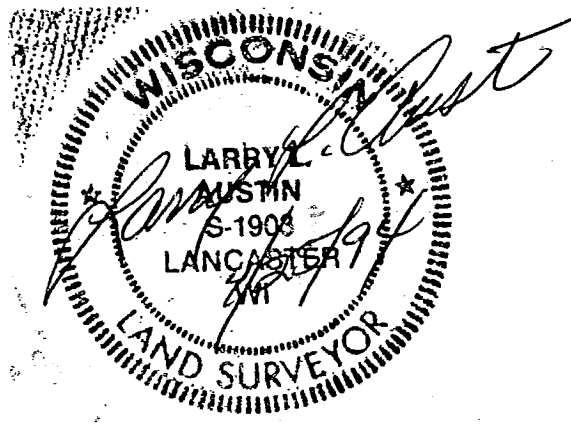

WOODWARDS  
ADDITION

DEDICATED FOR STREET PURPOSES  
VOL 476 PAGE 408