

SURVEY PLAT

MORTGAGE SURVEY


60

FOR: TELCO CREDIT UNION

AUGUST 9, 1994

SURVEY IS LOCATED IN THE NORTHWEST QUARTER (NW¹/₄) OF THE SOUTHWEST QUARTER (SW¹/₄) OF SECTION 7, T.6N., R.3W., GRANT COUNTY, WISCONSIN.

AUG 19 1994

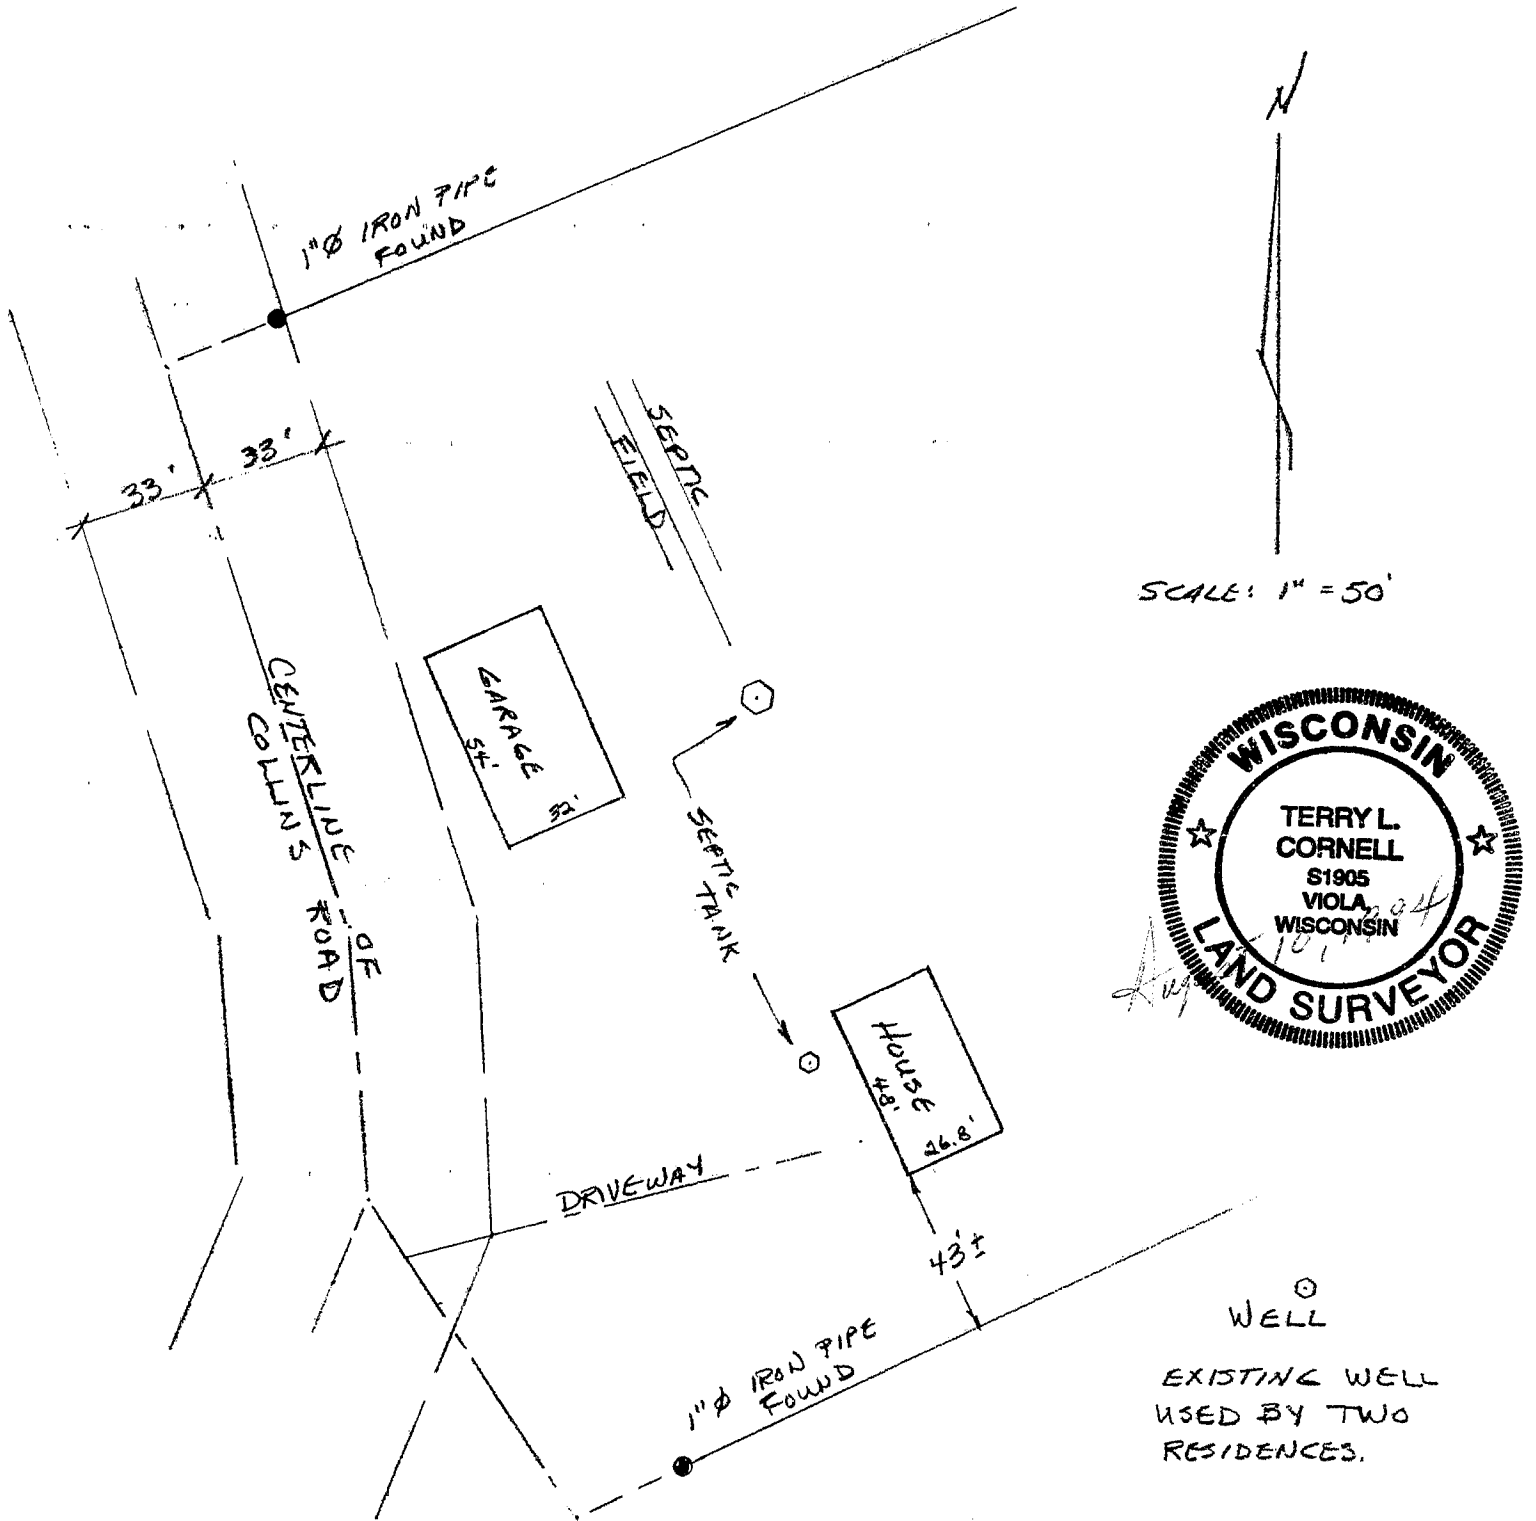

SCALE: 1" = 50'



WELL
EXISTING WELL
USED BY TWO
RESIDENCES.

This report is made for the exclusive use of the present owners of the property, and also those who purchase, mortgage or guarantee the title thereof, within one (1) year from the date hereof, and as to them I hereby certify that said report and the above map were made in accordance with acceptable professional standards and that the information contained hereon is to the best of my knowledge and belief a true and accurate representation thereof.

Terry L. Cornell
TERRY L. CORNELL
REGISTERED LAND SURVEYOR S-1905

WOODLAND CONSULTANTS, INC.
 Engineering, Land Surveying, Buildings & Soil Investigation
 P.O. Box 548
 755 Valley View Drive
 Richland Center, WI 53581-0548
 (608) 647-2191

1016.001