

MORTGAGE INSPECTION

PROESSLER: CASE 8212.T

FOR: MIDWEST TITLE
LANCASTER, WI

STATEMENTS REGARDING WORK TO BE DONE:

- AS CLIENT(S) OF LARRY L. AUSTIN, WISCONSIN LAND SURVEYOR, I/WE HEREBY REQUEST THAT THE WORK BE MADE ACCORDING TO THE FOLLOWING SPECIFICATIONS:
- 1) ONLY ENOUGH WORK BE PERFORMED TO SATISFY THE REQUIREMENTS OF: MIDWEST TITLE CORP. OF LANCASTER, WI
 - 2) NO STAKES BE SET TO MARK THE CORNERS OF THE PARCEL.
 - 3) THE EXACT LENGTH AND BEARINGS OF THE BOUNDARIES OF THE PARCEL NEED NOT BE SHOWN.
 - 4) MEASUREMENTS NEED NOT BE TAKEN AS SPECIFIED IN A-E 7.06 OF THE WISCONSIN ADMINISTRATIVE CODE. IT IS SPECIFICALLY INTENDED TO EXEMPT THIS WORK FROM THE REQUIREMENTS OF A-E 7.05 (3), 7.06 AND A-E 7.07 OF THE WISCONSIN ADMINISTRATIVE CODE.

DATE _____


SURVEYOR'S CERTIFICATE: I HEREBY CERTIFY THAT I HAVE MEASURED THE BELOW DESCRIBED PARCEL AND THAT THE MAP SHOWN HEREON IS A TRUE AND CORRECT REPRESENTATION THEREOF TO THE BEST OF MY KNOWLEDGE AND BELIEF, AND SHOWS THE SIZE AND LOCATION OF THE PARCEL, IT'S RECORDED EXTERIOR BOUNDARIES, THE LOCATION OF VISIBLE ROADWAYS AND ENCROACHMENTS, IF ANY. THIS SURVEY IS MADE FOR THE USE OF THE PRESENT OWNERS OF THE PROPERTY AND THOSE WHO PURCHASE, MORTGAGE, OR GUARANTEE TITLE THERETO WITHIN 6 MONTHS FROM THE DATE HEREON.

Larry L. Austin

 LARRY L. AUSTIN, RLS 1903
 LARRY AUSTIN ENGINEERING
 RT. 2
 LANCASTER, WISCONSIN 53813
 PHONE (608) 723-6363

DATE 9/19/94

DESCRIPTION TO BE USED*: All that parcel of land lying in the Southwest Quarter (S.W.1/4) of the Southeast Quarter (S.E.1/4) of Section Twelve (12), Township One (1) North, Range One (1) West of the 4th P.M., Grant County, Wisconsin, described as follows, to-wit: Commencing at the Southwest corner of the said Southeast 1/4 of said Section 12; thence East along the South line of said Section 12, 225.06 feet (3.41 chains) to the center of State Trunk Highway #80 and the point of beginning; thence North 14.5° East 247 feet 8 inches; thence East 3.09 chains, more or less, to the West boundary of John Altenburg's property; thence South 10° 10' West (with John Altenburgs West boundary as described in Volume 48, at Page 250, Grant County, Wisconsin) to a point 7.15 chains East of the Southwest corner of the Southeast 1/4 of said Section 12); thence West 3.74 chains (rec. as 3.24 chains) along the South line of said Section 12 to the point of beginning.

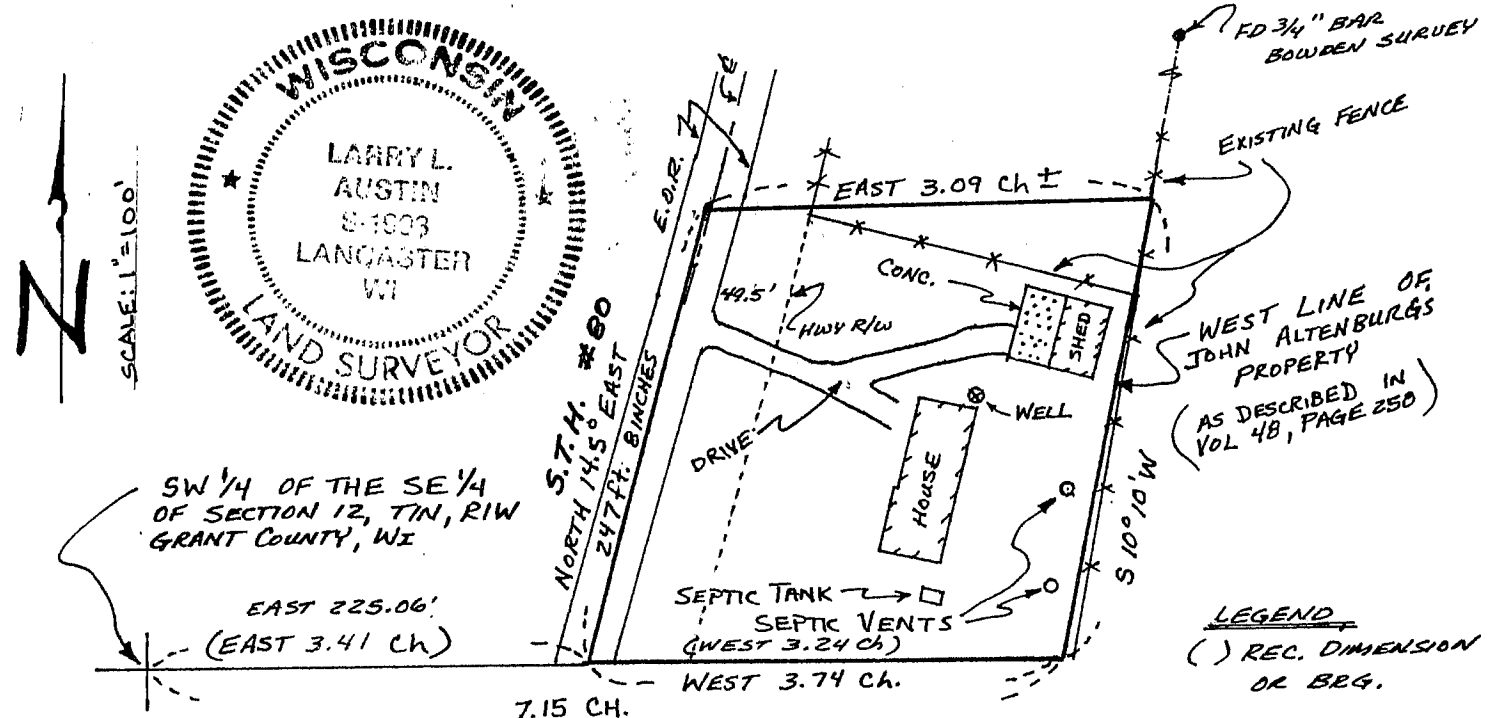

* THE ORIGINAL DESCRIPTION WAS MODIFIED TO MATCH THE ALTENBURG DESCRIPTION AT VOL 48, PAGE 250, GRANT CO. REGISTRY.