

REC'D SEP 21 1995  
**SURVEY PLAT**

101


-TIM BALIFF  
 -DDCFB9506PW7

Of a parcel of land located in the SE 1/4 of Section 27, T 3 N, R 5 W of the 4th P.M., Grant County, Wisconsin, and being more particularly described as follows:

Commencing at the E 1/4 corner of Section 27, T 3 N, R 5 W of the 4th P.M., Grant County, Wisconsin, thence N 89°19'53" W 1139.97' along the East-West 1/4 line to the point of beginning;  
 thence N 89°19'53" W 355.31' to a point in the center line of S.T.H. #133;  
 thence Southwesterly 344.84' along said center line on the arc of a curve concave Easterly having a radius of 858.83' and a long chord which bears S 04°54'21" W 342.53';  
 thence S 06°35'49" E 241.90' along said center line;  
 thence Southeasterly 94.37' along said center line on the arc of a curve concave Westerly having a radius of 573.00' and a long chord which bears S 01°52'48" E 94.26';  
 thence N 77°22'18" E 471.92';  
 thence N 10°38'29" W 578.41' to the point of beginning containing 6.187 acres, more or less, and being subject to any and all easements of record, including, but not limited to a R.O.W. for S.T.H. #133 as shown on the attached plat.

SURVEYOR'S CERTIFICATE: I, Larry L. Austin, Registered Wisconsin Land Surveyor do hereby certify that the above survey, description and plat were prepared by me or under my direct supervision, in accordance with the instructions of Tim Baliff, and to the best of my knowledge and belief, this plat is an accurate representation thereof.

*Larry L. Austin*  
 LARRY L. AUSTIN RLS 1903  
 LARRY AUSTIN ENGINEERING  
 RT. 2  
 LANCASTER, WI 53813  
 PHONE (608) 723-6363

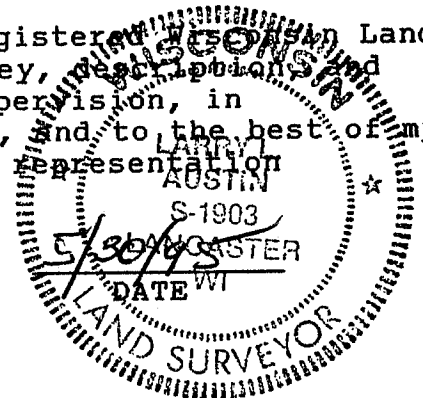

BEARING REFERENCE: For purposes of this survey bearings are referenced to the East-West 1/4 line of Section 27 which is assumed to bear S 89°19'53" E.

