


SURVEY PLAT

- PAUL STOLLER
- MUBK108FB9605PW13

Lot 4, Lot 5, and Lot 6 of Block 108 of the Original Plat of Muscoda, being located in part of the Northeast 1/4 of Section 12, T 8 N, R 1 W, Village of Muscoda, Grant County, Wisconsin.

SURVEYOR'S CERTIFICATE: I, Larry L. Austin, Registered Wisconsin Land Surveyor, do hereby certify that the above survey, description, and plat were prepared by me or under my direct supervision, in accordance with the instructions of Paul Stoller, and to the best of my knowledge and belief, this plat is an accurate representation thereof.

Larry L. Austin
LARRY L. AUSTIN RLS 1903
AUSTIN ENGINEERING
4211 HWY 81 E
LANCASTER, WI 53813
PHONE (608) 723-6363

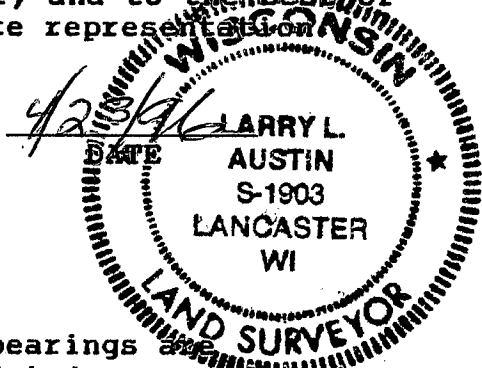

BEARING REFERENCE: For purposes of this survey bearings are referenced to the West line of the Block 108 which is assumed to bear N 00° 01' 12" W.

LEGEND

- △ 3/4" x 24" IRON BAR SET
- ▲ FOUND 3/4" IRON BAR
- FOUND 1" IRON PIPE
- FOUND 1" IRON BAR
- FOUND 2" IRON PIPE

NOTE: BLOCK 108 RETRACED FROM A 1992 SURVEY BY M. JANIAK

