



65

PLAT OF SURVEY FOR JACK KINNEY

LOCATED IN PART OF THE NORTHWEST ONE-QUARTER OF THE NORTHEAST ONE-QUARTER OF SECTION 19
AND PART OF THE SOUTHWEST ONE-QUARTER OF THE SOUTHEAST ONE-QUARTER OF SECTION 18, ALL IN
TOWNSHIP 8 NORTH, RANGE 2 WEST, TOWN OF WATTERSTOWN, GRANT COUNTY, WISCONSIN.

BASIS OF BEARINGS:
THE NORTH LINE OF THE NE 1/4
OF SECTION 19 ASSUMED TO
BEAR N 89° 49' 00" W

SCALE: 1" = 100'

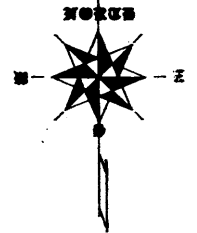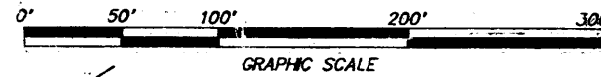

N 89° 49' 00" W 2682.94'
NORTH LINE OF THE NORTHEAST ONE-QUARTER SECTION 19

AREA OF PARCEL
21,140 SQ. FT.
0.485 ACRES

NORTH ONE-QUARTER CORNER
SECTION 19, T8N, R2W
3/4" IRON ROD LOCATED

NORTHEAST CORNER
SECTION 19, T8N, R2W
2" DIA IRON PIPE LOCATED



Revised Plat Line 9-27-96
at request of Mr. Jack Kinney

- LEGEND**
- --- INDICATES 3/4" X 24" IRON ROD PLACED (1.5 LBS / FT.)
 - --- INDICATES 3/4" IRON ROD LOCATED

I HAVE SURVEYED THE PROPERTY DEPICTED HEREON AND THIS IS A CORRECT REPRESENTATION THEREOF AND SHOWS THE SIZE AND LOCATION OF THE PROPERTY, ITS EXTERIOR BOUNDARIES, THE LOCATION AND DIMENSIONS OF ALL STRUCTURES THEREON, ROADWAYS AND ANY VISIBLE ENCROACHMENTS, IF ANY.

THIS SURVEY IS MADE FOR THE EXCLUSIVE USE OF THE PRESENT OWNERS OF THE PROPERTY, AND ALSO THOSE WHO PURCHASE, MORTGAGE OR GUARANTEE THE TITLE THEREOF, WITHIN ONE (1) YEAR HEREOF; AND AS TO THEM I HEREBY CERTIFY THAT SAID SURVEY AND THIS MAP WERE MADE IN ACCORDANCE WITH ACCEPTABLE PROFESSIONAL STANDARDS AND THE INFORMATION CONTAINED HEREON IS TO THE BEST OF MY KNOWLEDGE, INFORMATION AND BELIEF A TRUE REPRESENTATION THEREOF.

BENCHMARK SURVEYS

OF SW. WIS., INC.
P. O. BOX 486, 133 N. CENTRAL AVE., RICHLAND CENTER, WI 53581
(608) 647-8533

JOB NUMBER 1418
SHEET 1 OF 2

DR. BY: SMW
SEPTEMBER, 1996

DESCRIPTION FOR: JACK KINNEY

All that part of the Northwest One-quarter of the Northeast One-quarter of Section 19 and part of the Southwest One-quarter of the Southeast One-quarter of Section 18, all in Township 8 North, Range 2 West, Town of Watterstown, Grant County, Wisconsin, bounded and described as follow:

Commencing at the North One quarter of Section 19; thence South 89° 49' 00" East, along the North line of the Northeast One-quarter of Section 19, 886.00 feet to the point of beginning of the parcel hereinafter described; thence North 00° 55' 32" West, 9.42 feet; thence North 82° 14' 10" East, along an existing fenceline, 286.12 feet to a point on the Northerly right-of-way line of Wisconsin State Trunk Highway "133"; thence South 56° 34' 36" West, along said right-of-way line, 340.02 feet; thence North 00° 11' 00" East, 139.22 feet to the point of beginning, containing 21,140 square feet or 0.485 acres of land.



Sheet 2 of 2

	INDICATED	1.5 LBS / FT.)
RK SURVEYS W.S., INC. AVE. RICHLAND CENTER, WI 53581 647-8533		
DR. BY: SMW SEPTEMBER 1996		