



MORTGAGE SURVEY

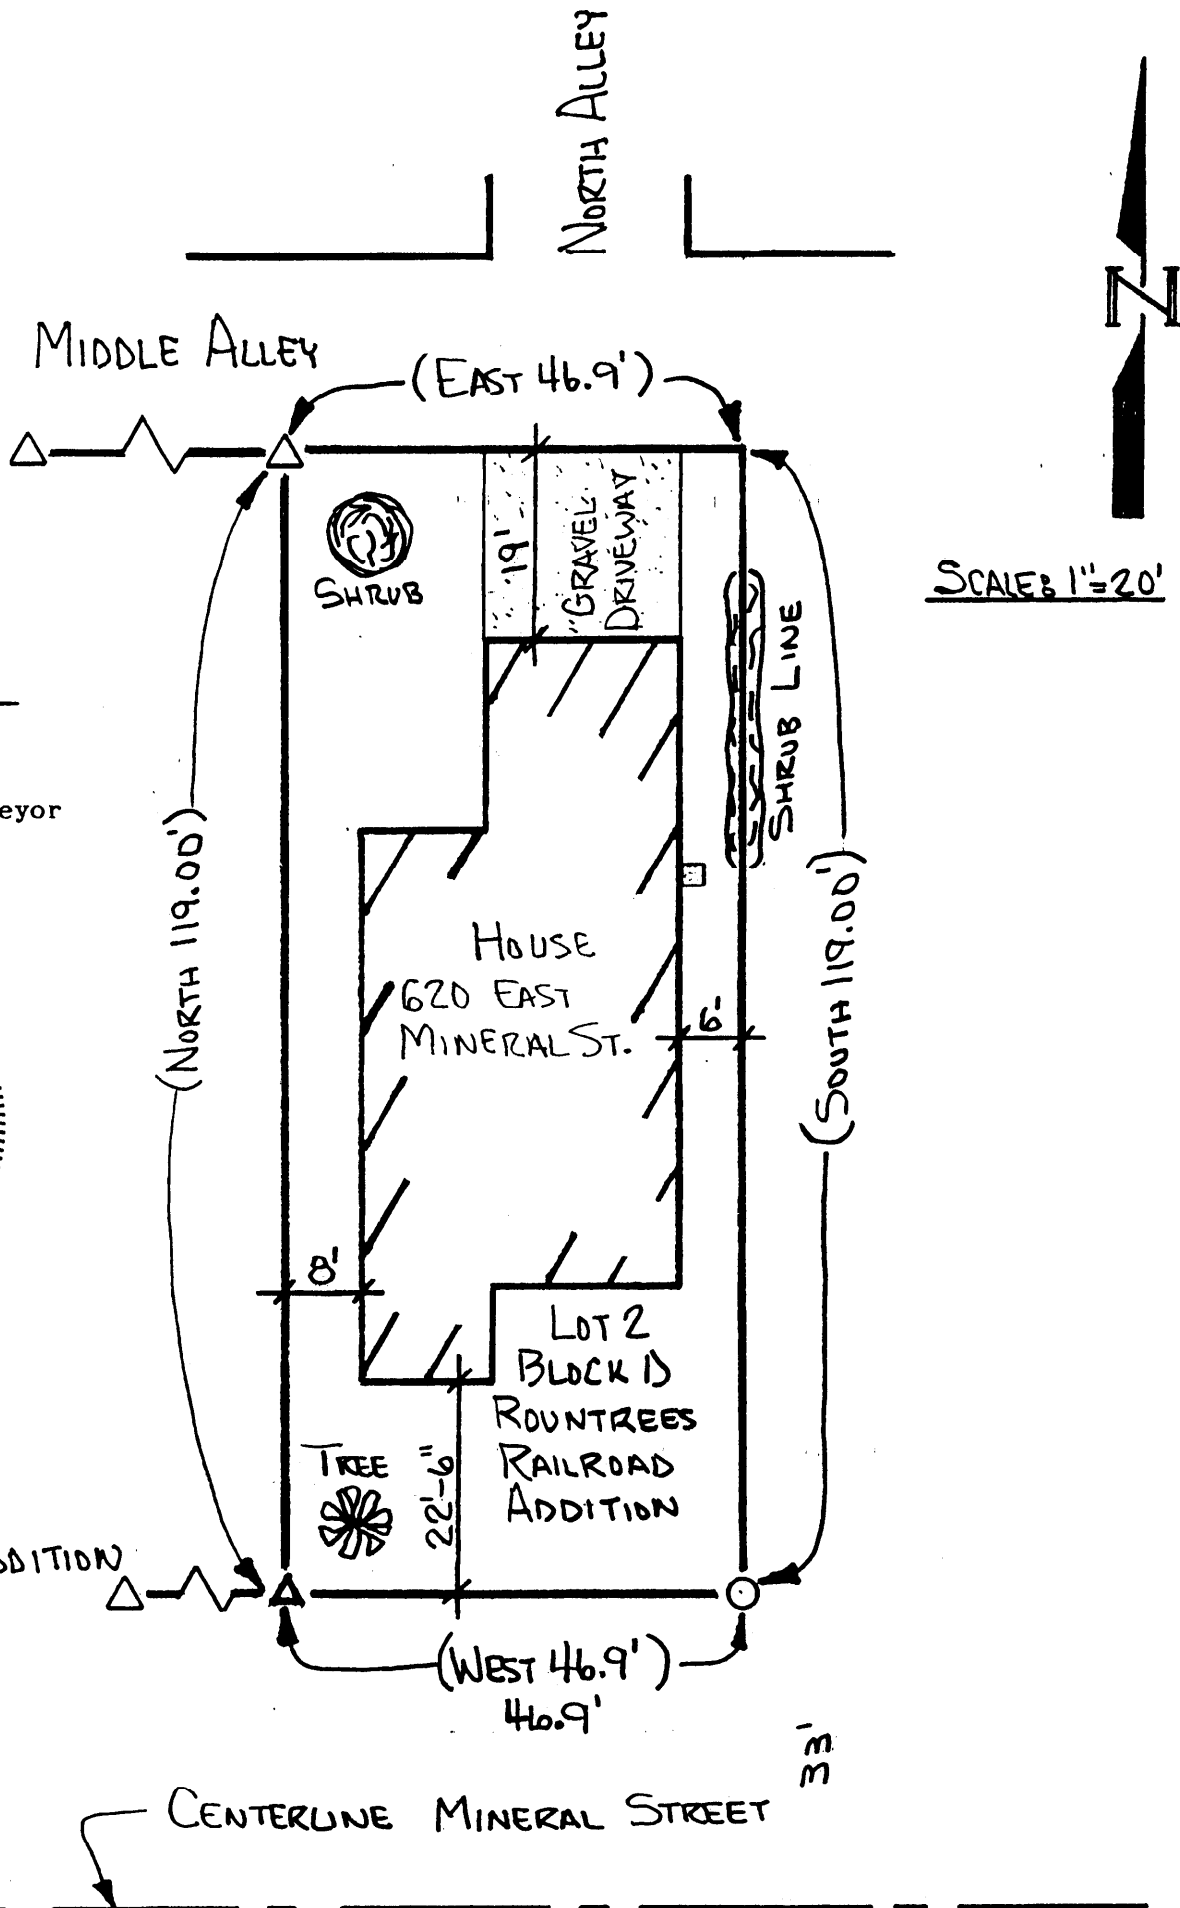

David F. Burbach

David F. Burbach
S-2019
Registered Land Surveyor

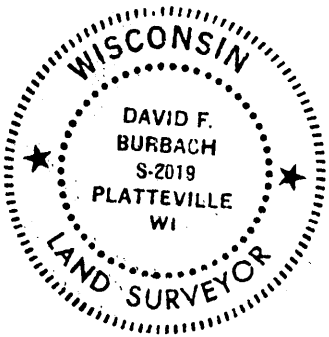

LOT 3
BLOCK D
ROUNTREES
RAILROAD ADDITION

LOT 2
BLOCK D
ROUNTREES
RAILROAD
ADDITION

- ▲ FOUND 1/2" ROUND IRON BAR
- △ FOUND 3/4" ROUND IRON BAR
- FOUND 1" IRON PIPE

BURBACH MUNICIPAL & CIVIL ENGINEERS

LEGAL DESCRIPTION:

The West 40 feet of Lot Two (2) and the East 6.9 feet of Lot Three (3) in Block "D" of Rountree's Railroad Addition to the Village (now City) of Platteville, Grant County, Wisconsin, according to the recorded map or plat thereof.

SURVEYOR'S NOTE:

As clients of Burbach Municipal & Civil Engineers, I/we request that the inspection be made according to the following specifications:

1). Only enough work be performed to satisfy the requirements of the lending institution.

2). Only recorded (Deed) distances and bearings be shown.

It is specifically intended to exempt this inspection from the requirements of A-E 7.03, A-E 7.05(2), (3), and (4) and A-E 7.06 of the Wisconsin Administrative Code, and is so stated and agreed to as required by A-E 7.01(2).

Samuarez Dated

CERTIFICATE: I hereby certify that I have inspected the above described parcel and that the above map is a true representation thereof and shows the approximate location of the parcel, its recorded exterior boundaries, the location of all visible roadways and encroachments, if any. This inspection is made for the use of the purchasers' mortgage institution and is valid for one-half year from the date hereof. I further certify that such inspection and the representation thereof hereon are true and correct to the best of my knowledge and belief.

David F. Burbach 7/26/91
David F. Burbach
S-2019
Registered Land Surveyor