

NF22

Dixon and Orth

Registered Engineers and Surveyors


PLATTEVILLE, WIS. 53818

June 14, 1975

DALE DIXON
155 Preston Drive
Telephone 348 6408

JOHN ORTH
65 Elmer Street
Telephone 348 5731

Don Miles Property
Platteville Twp.

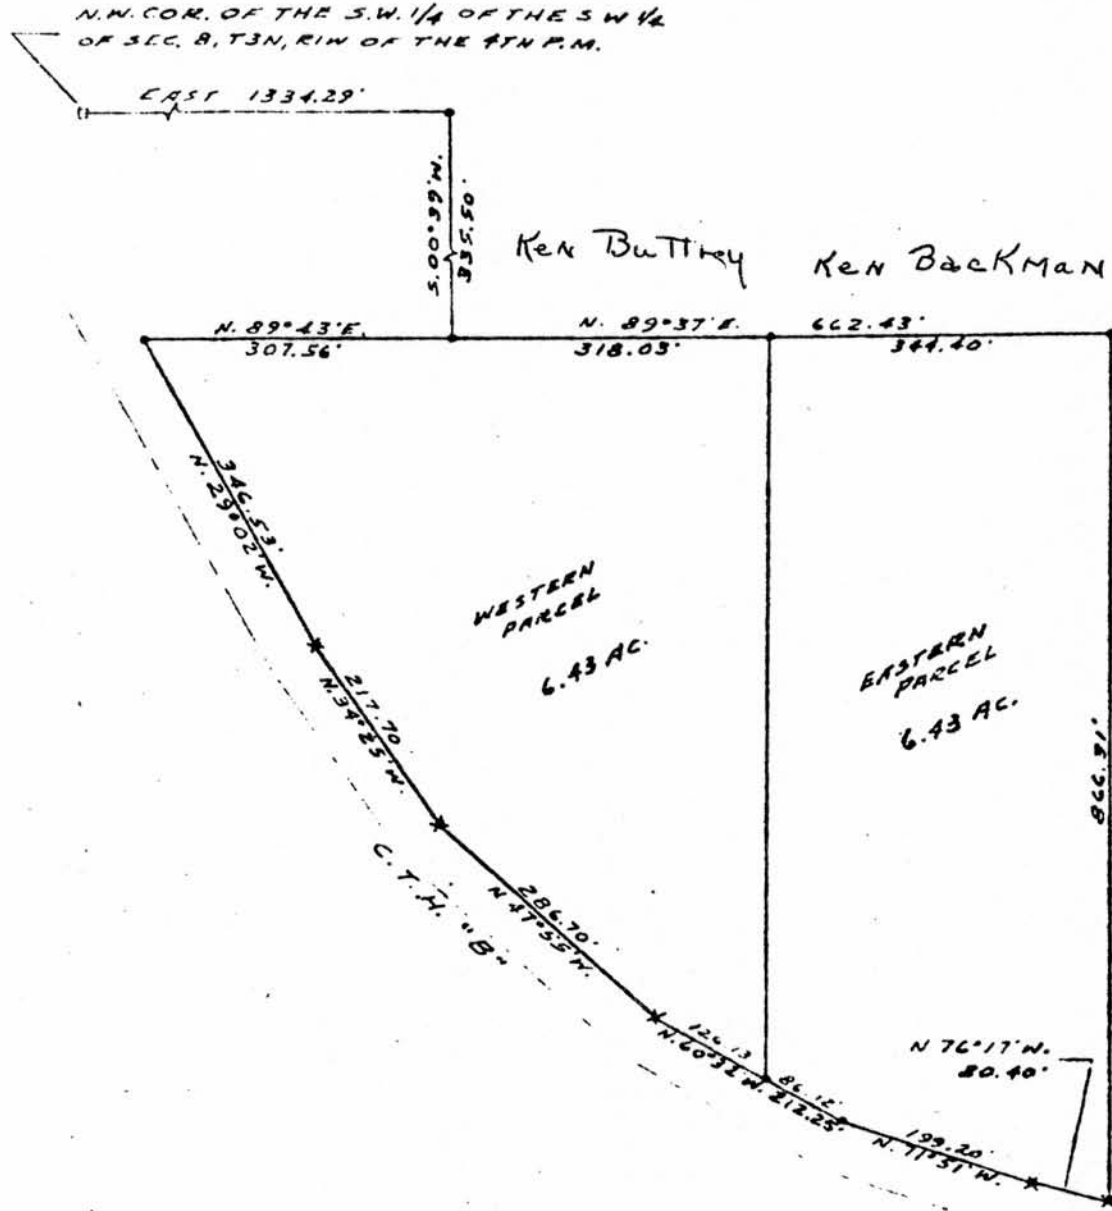

SCALE: 1" = 200'
● IRON PIPE
✱ R/W MARKERS

