

NF 29

MORTGAGE INSPECTION SURVEY

MR: MIDWEST TITLE CORP., LANCASTER, WI

#1483


FAHERTY-TURNER

A part of the North Half (N.1/2) of the Northwest Quarter (N.W.1/4) of Section Nineteen (19), Township Three (3) North, Range One (1) West of the 4th P.M., Grant County, Wisconsin, described as follows:

Commencing at the Northwest corner of the N.E.1/4 of the N.W.1/4 of said Section 19;
thence West 202.07 feet to the center of Stumptown Road and the point of beginning;
thence along the center of said Stumptown Road the following 8 courses:
South 42° 00' West 53.00 feet;
thence South 17° 58' West 55.25 feet;
thence South 06° 50' East 54.11 feet;
thence South 24° 03' East 77.11 feet;
thence South 32° 02' East 99.90 feet;
thence South 36° 41' East 199.18 feet;
thence South 33° 02' East 150.10 feet;
thence South 46° 12' East 81.55 feet;
thence Southwesterly from Stumptown Road, South 58° 14' West 566.81 feet;
thence North 08° 32' West 207.59 feet;
thence North 19° 29' West 531.40 feet;
thence North 07° 00' West 231.05 feet to the center of Ridge Road;
thence North 89° 16' East 420.00 feet along said Ridge Road to the point of beginning, containing 8.11 acres, more or less.

EXCEPT for the following parcel of land:
Commencing at the Northwest corner of the N.E.1/4 of the N.W.1/4 of said Section 19;
thence West 202.07 feet to the center of Stumptown Road;
thence South 89° 16' West 285.00 feet along the center of Old Ridge Road to the point of beginning;
thence South 11° 45' East 371.33 feet;
thence South 89° 16' West 135.00 feet;
thence North 19° 29' West 142.37 feet;
thence North 07° 00' West 231.05 feet to the center of old Ridge Road;
thence North 89° 16' East 135.00 feet to the point of beginning, containing 1.21 acres, more or less.

Also EXCEPT a parcel of land deeded to Platteville Township by Warranty Deed recorded in Volume 666 of Records, page 592 on April 3, 1990.

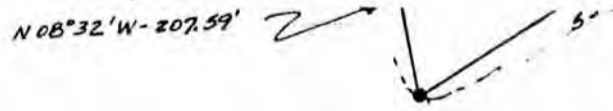

LEGEND
● FOUND IRON PIPE

* APPARENT ENCROACHMENT OF SEWER VENT FOUND ON PROPERTY LINE.

