

PLAT OF SURVEY

For: Don Friederick/
Randy Timmerman

STH 35/
USH 61

R/W

Roadway easement:

- a- N80°18'00"W, 38.80'
- b- N86°45'40"W, 39.97'
- c- S52°10'00"W, 33.68'
- d- S05°18'40"W, 62.31'
- e- S18°29'30"E, 269.77'

N87°56'30"E,
91.50'

ASSUMED NORTH




Bearings referenced to the westerly
line of the SE 1/4 Sec. 7, T2N, R2W.
Assumed bearing-N0°41'09"W

Scale: 1" = 200'

Legend:

- - 1"x24" iron pipe set
- - RR spike set
- × - existing fence

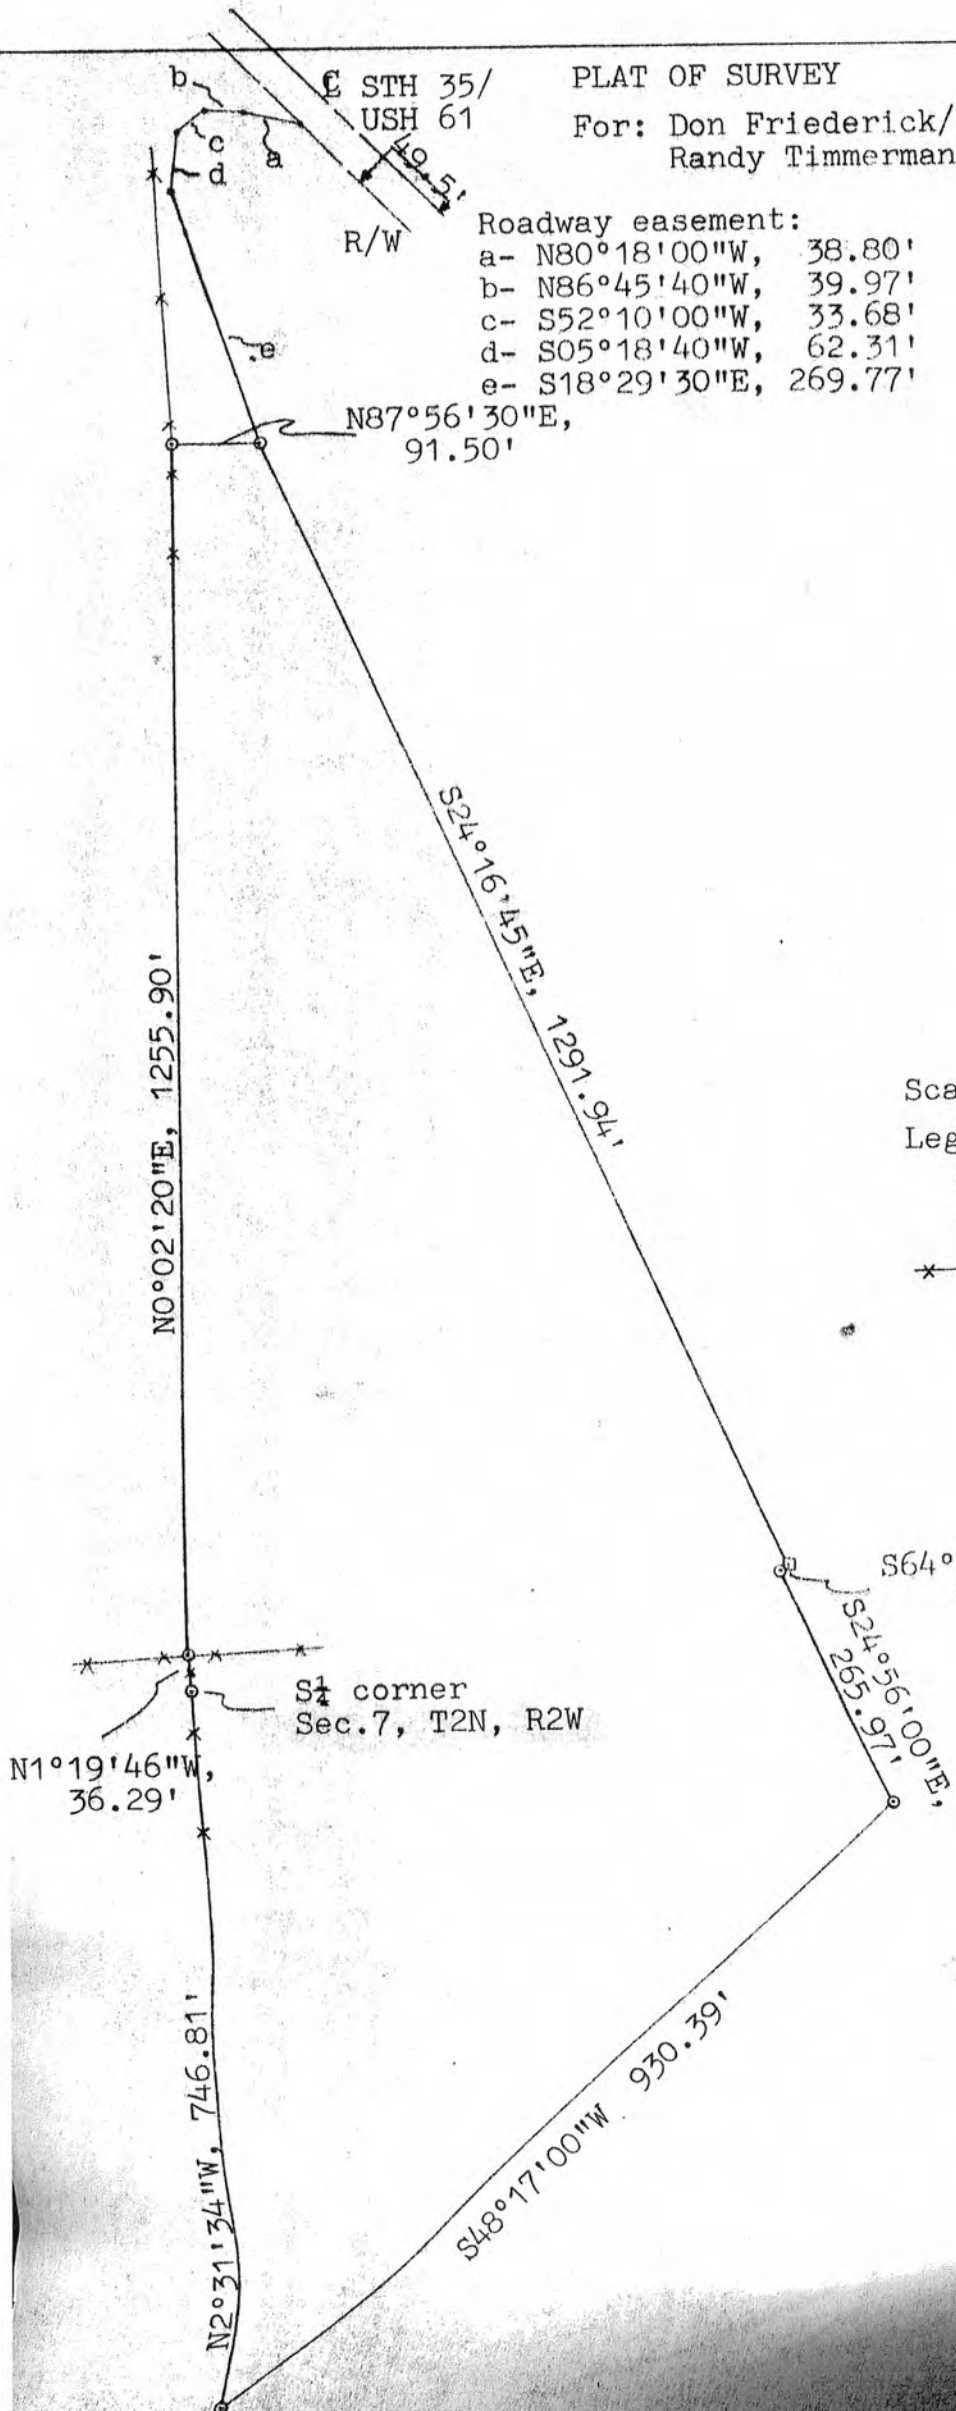

Revised: May 15, 1978
Ofc. No.: 78S019
Fld. Bk.: 26
Survey: Mar. 1978, BP/GJ
Drawn: BJ



PLAT OF SURVEY

SHEET 2 of 2 SHEETS

For: Don Friederick/
Randy Timmerman

PARCEL DESCRIPTION

A parcel of land located in the NW $\frac{1}{4}$ -NE $\frac{1}{4}$ of Section 18 and in the SW $\frac{1}{4}$ -SE $\frac{1}{4}$ of Section 7, all in T2N, R2W, Town of Paris, Grant County, Wisconsin, more particularly described as follows:

Beginning at a 1" iron pipe marking the South $\frac{1}{4}$ corner of said Sec. 7; thence N1°19'46"W, 36.29'; thence N0°02'20"E, 1255.90'; thence N87°56'30"E, 91.50'; thence S24°16'45"E, 1291.94'; thence S64°25'00"W, 8.22'; thence S24°56'00"E, 265.97'; thence S48°17'00"W, 930.39'; thence N2°31'34"W, 746.81' to the point of beginning.

Said parcel contains 18.55 acres, more or less.

ROADWAY EASEMENT DESCRIPTION

A strip of land located in the NW $\frac{1}{4}$ -SE $\frac{1}{4}$ of Section 7, T2N, R2W, Town of Paris, Grant County, Wisconsin, more particularly described as follows:

Commencing at a 1" iron pipe marking the South $\frac{1}{4}$ corner of said Sec. 7; thence North, 1625.31'; thence East, 115.91' to the point of beginning of a strip of land 30' wide and lying 15' on each side of the following described reference line, said point also lying on the SW'ly right-of-way line of S.T.H. 35/U.S.H. 61; thence N80°18'00"W, 38.80'; thence N86°45'40"W, 39.97'; thence S52°10'00"W, 33.68'; thence S5°18'40"W, 62.31'; thence S18°29'30"E, 269.77' to the point of termination of said reference line and strip description. Also, extending the sidelines of said described strip so as to intersect.

Said strip contains 0.30 acres, more or less.


Revised: May 15, 1978

SURVEYOR'S CERTIFICATE

I hereby certify that I have made a survey according to the instructions furnished to me and that the plat drawn hereon is correct representation of that survey to the best of my knowledge and belief.

It is intended that this survey will be used to obtain quit claim deeds to the northerly and westerly lines thereof.

Laurence E Schmit 4-3-78
Laurence E. Schmit, RLS# S-1312
Southwest Engineering, Inc.
501 W. North St.
Dodgeville, Wis., 53533

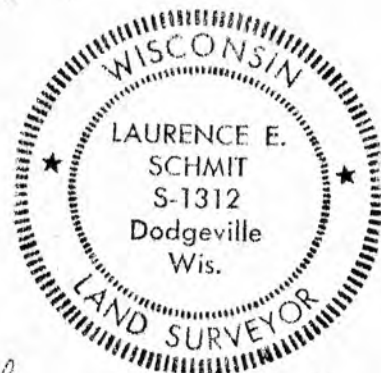

Laurence E Schmit
4-3-78