


723-4558

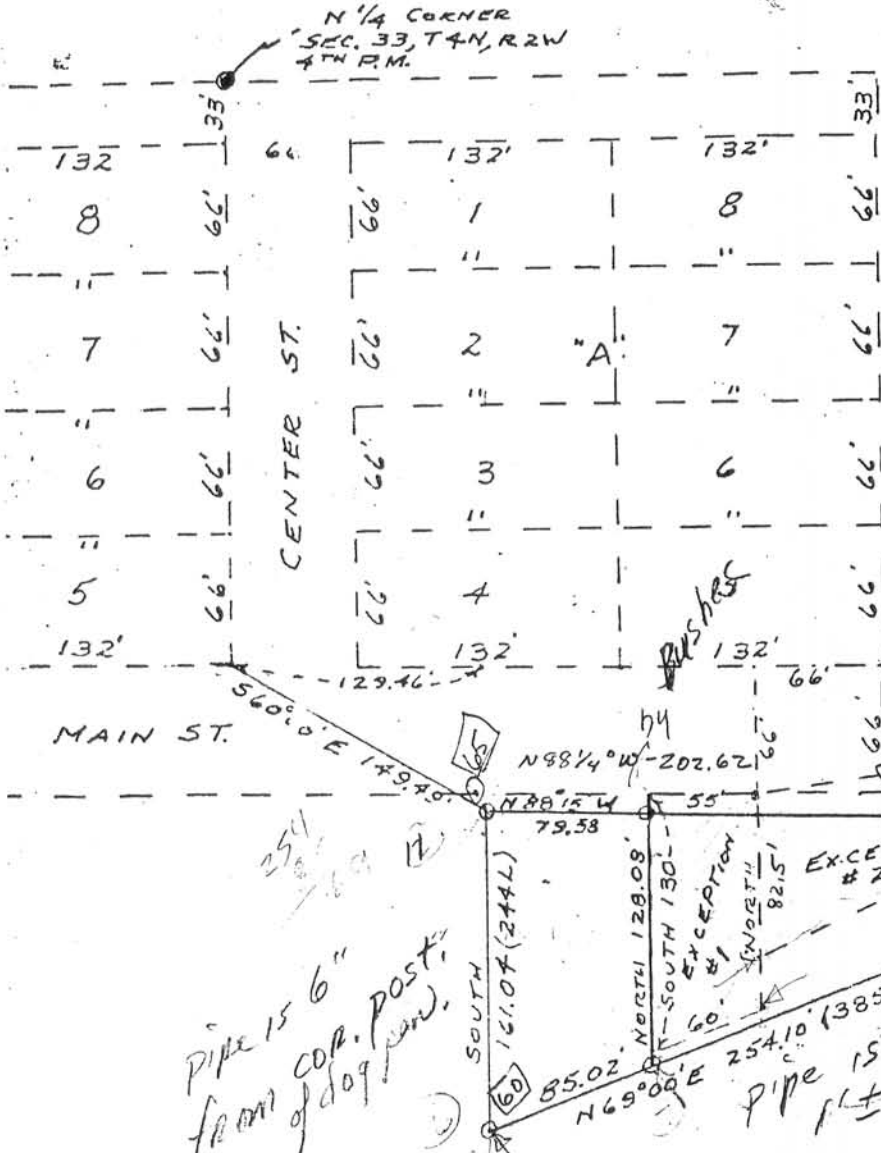

SCALE 1"=100'

LEGEND

- Iron pipe found
- 1"x24" iron pipe set



I, Dale C. Dixon, registered surveyor, hereby certify that I retraced the property lines from the descriptions given in the abstract, and that the survey is correct to the best of my knowledge and belief.

Dale C. Dixon S-304
Dale C. Dixon

Surveyed for: John W. Friedrich, Rt. 2, Lancaster, Wis.

Date: 5/15/81

Surveyor's Note:

The original description of the entire parcel does not close by 3.65 ft in the N-S direction and 1.36 ft. in the E-W direction. The exceptions do not fall entirely in the original parcel as described. The description shown as entry No. 49, 3383-71 in the abstract creates an overlap on the parcel description given in the caption on the West side.