

Total Area = 2.572 Aci

Surveyed for
Louis and Milred Wendt

PLAT OF SURVEY

PARCEL 1: COMMENCING FIFTY (50) FEET EAST AND TEN (10) FEET SOUTH OF THE SOUTHWEST CORNER OF THE NORTHWEST QUARTER OF THE NORTHWEST QUARTER (NW $\frac{1}{4}$ -NW $\frac{1}{4}$) OF SECTION NUMBER SIX (6), TOWN NUMBER FIVE (5) NORTH, RANGE NUMBER SIX (6) WEST, RUNNING TWO HUNDRED FIFTY (250) FEET EAST, THENCE ONE HUNDRED (100) FEET SOUTH, THENCE TWO HUNDRED FIFTY (250) FEET WEST, THENCE ONE HUNDRED (100) FEET NORTH TO PLACE OF BEGINNING, SAID PARCEL OF LAND BEING LOCATED IN THE NORTHWEST CORNER OF THE SOUTHWEST QUARTER OF THE NORTHWEST QUARTER (SW $\frac{1}{4}$ -NW $\frac{1}{4}$) OF SAID SECTION NUMBER SIX (6), EXCEPT A STRIP FORTY (40) FEET WIDE RUNNING NORTH AND SOUTH THROUGH THE CENTER OF THE ABOVE DESCRIBED PREMISES FOR A PUBLIC HIGHWAY.



PARCEL 2: COMMENCING FIFTY (50) FEET EAST OF THE SOUTHWEST CORNER OF THE NORTHWEST QUARTER OF THE NORTHWEST QUARTER (NW $\frac{1}{4}$ -NW $\frac{1}{4}$) OF SECTION NUMBER (6) SIX, TOWN FIVE (5) NORTH, RANGE NUMBER SIX (6) WEST, RUNNING TWO HUNDRED FIFTY (250) FEET EAST, THENCE TEN (10) FEET SOUTH, THENCE ONE HUNDRED TEN (110) FEET WEST, THENCE ONE HUNDRED (100) FEET SOUTH, THENCE FORTY (40) FEET WEST, THENCE RUNNING ONE HUNDRED (100) FEET NORTH, THENCE RUNNING ONE HUNDRED (100) FEET WEST, THENCE TEN (10) FEET NORTH TO THE PLACE OF BEGINNING, SAID PARCEL OF LAND BEING LOCATED IN THE SOUTHWEST QUARTER OF THE NORTHWEST QUARTER (SW $\frac{1}{4}$ -NW $\frac{1}{4}$) OF SAID SECTION NUMBER SIX (6).

PARCEL 3: COMMENCING AT A POINT WHICH IS THREE HUNDRED (300) FEET EAST OF THE SOUTHWEST CORNER OF THE NORTHWEST QUARTER OF THE NORTHWEST QUARTER (NW $\frac{1}{4}$ -NW $\frac{1}{4}$) OF SECTION NUMBER SIX (6), TOWN NUMBER FIVE (5) NORTH, RANGE NUMBER SIX (6) WEST OF THE 4TH P. M. IN GRANT COUNTY, WISCONSIN, THENCE SOUTH ONE HUNDRED TEN (110) FEET, THENCE EAST SIX HUNDRED EIGHTY (680) FEET, THENCE RUNNING IN A NORTHEASTERLY DIRECTION TO INTERSECT THE NORTH LINE OF SAID FORTY ACRE TRACT AT A POINT FIFTY (50) WEST OF THE NORTHEAST CORNER OF THE SOUTHWEST QUARTER OF THE NORTHWEST QUARTER (SW $\frac{1}{4}$ -NW $\frac{1}{4}$), THENCE RUNNING WEST TO THE PLACE OF BEGINNING.

I, PAUL C. BRASHAW, A WISCONSIN REGISTERED LAND SURVEYOR, NO S-1509, DO HEREBY CERTIFY THAT THE REQUEST OF LOUIS E. WENDT AND MILRED WENDT, I HAVE BEEN FURNISHED THE ABOVE DESCRIBED LEGAL DESCRIPTION AS IT APPEARS AND IS RECORDED IN VOLUME 357, PAGE 284, IN THE GRANT COUNTY REGISTER OF DEEDS OFFICE AND THAT I HAVE MADE A RESURVEY OF THE ABOVE DESCRIBED TRACT BASED ON THIS LEGAL DESCRIPTION TO ESTABLISH THE BOUNDARY LINES AS SHOWN. THE RESULTS OF MY RESURVEY APPEAR ON THE ACCOMPANYING PLAT AND THAT THE COURSES AND DISTANCES OF THE RESURVEY MADE VARY FROM THE RECORDED CALLS BASED ON THE EXISTENCE OF FOUND MONUMENTATION, OCCUPATION, OR OTHER CONTROLLING CALLS OR CONDITIONS THAT HAVE OCCURRED IN THE PREFORMANCE OF THIS RESURVEY. I FURTHER CERTIFY THAT I HAVE FOUND AND/OR SET THE SURVEY MONUMENTS ALL AS SHOWN AND THAT THERE ARE NO APPARENT ENCROACHMENTS EXCEPT AS SHOWN ON THE ACCOMPANYING PLAT.

SIGNED AND SEALED THIS 21TH DAY OF MARCH, 1983.

Paul C. Brashaw

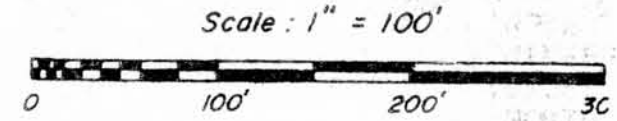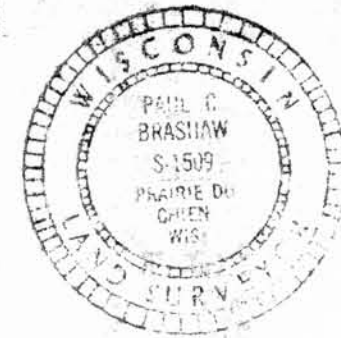

Legend

- Boundary of the Property Surveyed
- 5/8"x30" Iron Rebar Set
- 3/4" Iron Rebar Found
- △ P. K. Nail Found
- 0.00' Measured Distance/Bearing
- (10.00') Deeded Distance/Bearing



Snyder Brashaw Engineerit.

Note: For the purposes of this survey, the West Line of the Northwest 1/4 of Section 6, T5N, R6W of the 4th P.M., is assumed to bear N.00°54'15"E.

NW Corner, Southwest 1/4, Northwest 1/4 Sec. 6
 T5N, R6W of the 4th P.M.

S.00°54'15"W 1324.26'

Otis Street

N.00°54'15"E.

West 1/4 Corner of Sec. 6
 T5N, R6W of the 4th P.M.