


PLAT OF SURVEY

FOR DAVE SWENSON

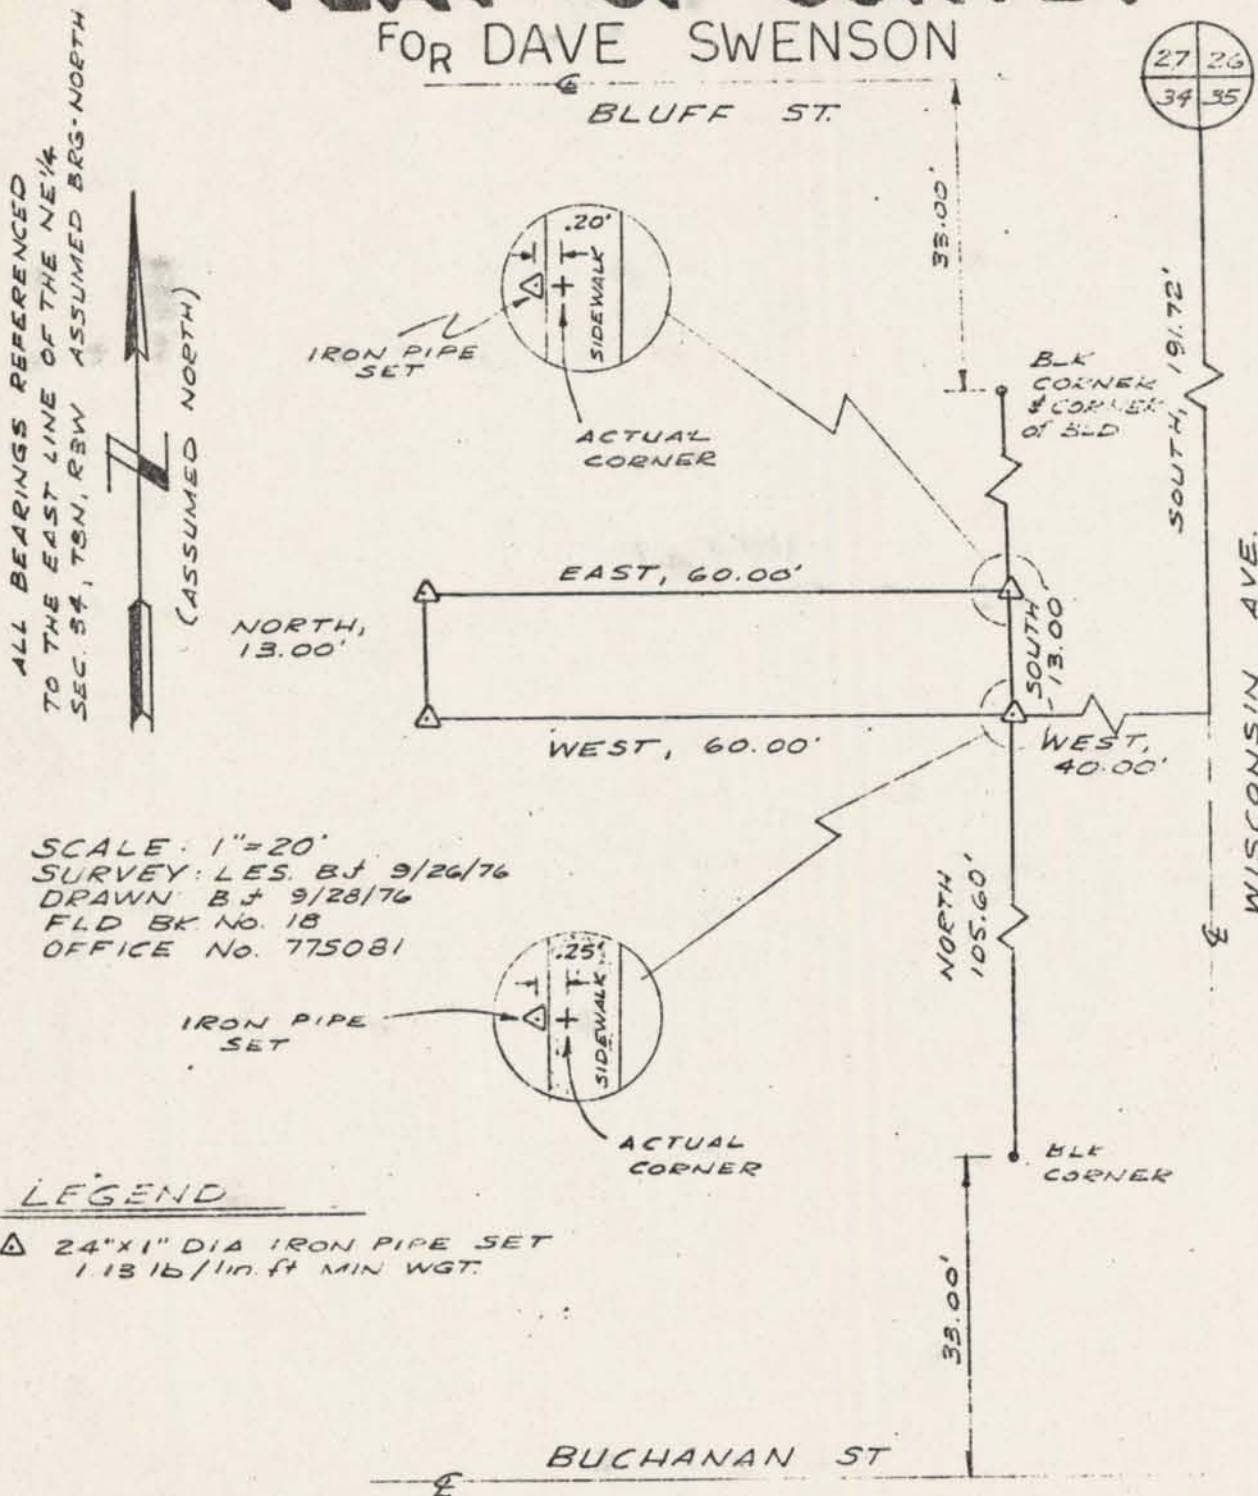

A parcel of land located in a part of Lot 3, Block 1 of Parker's Addition to the City of Boscobel, Grant County, Wisconsin, more particularly described as follows:

Beginning at the SE corner of said Lot 3, said point also being located South, 191.72' and West, 40.00' from the NE corner of Section 34, T8N, R3W, City of Boscobel; thence West, 60.00'; thence North, 13.00'; thence East, 60.00'; thence South, 13.00' to the point of beginning. Said parcel contains 0.18 acres.

I hereby certify that I have made a survey according to the description furnished to me and that the plat drawn hereon is a true representation of that survey.

Laurence E. Schmit 10/5/77
 Laurence E. Schmit, S-1312
 Southwest Engineering, Inc.
 501 W. North St.
 Dodgeville, Wis., 53533
 (608)935-3828

