


# SECTION CORNER TIE SHEET INDEX

T. I. N., R. I. W

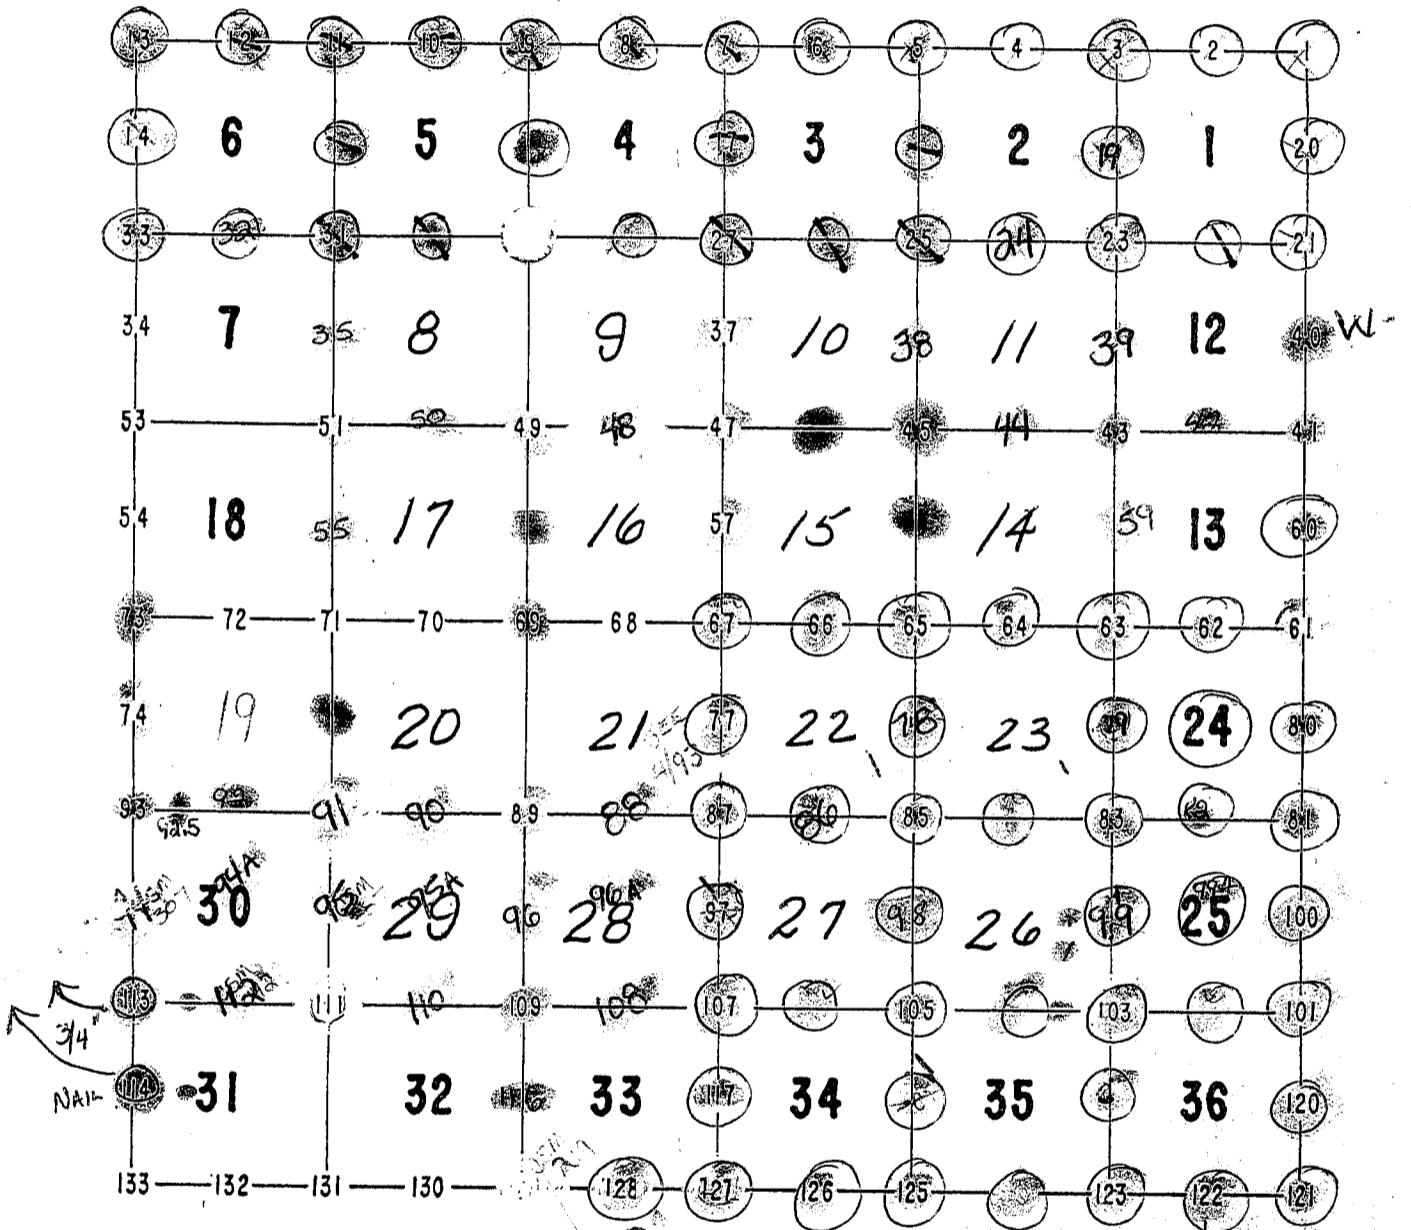

NOTE SHEET #6 REBAR TIE FOR SW 34

111-1-06

3  
17  
32  
74

90 Corners  
10-12-94

