


# U.S. PUBLIC LAND SURVEY MONUMENT RECORD

Section 17, Town 1 North Range 1 West, Town of Hazel Green, Grant County, Wisconsin

## CERTIFICATE

I, Larry L. Austin, do hereby certify that the corner location on this record was determined by me and/or under my direct supervision and that this U.S. public land survey monument record is correct and complete to the best of my knowledge and belief.

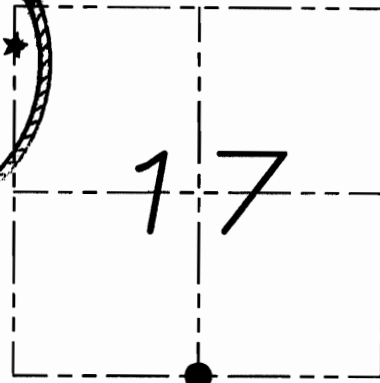

● = CORNER LOCATION

*Larry L. Austin*  
Larry L. Austin, S-1903

6.8.09  
date

## HISTORY OF CORNER

Corner was originally set in the 2nd quarter of 1832. Many various surveyors tied to the corner in the 1800's. No other recent record of the corner was found.

## CORNER EVIDENCE FOUND


I reset the corner at an occupied location. Verified this location using EDM & GPS methods.

**DESCRIPTION OF CORNER AND WITNESS MONUMENTS, references and accessories used to perpetuate the original or re-established location of this corner. Witnesses to monument location Bobby Sedgwick & Brad Digman & Shelby Blindert**

## SKETCH:

FIELDS

FIELDS

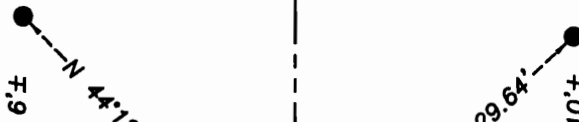

HYVIEW

ROAD

## LEGEND

- Number 8 x 30" rebar set with Grant County Aluminum cap
- Number 4 x 24" Rebar set with red plastic "TIE" cap
- x- Approximate existing fence

NORTHING: 415,571.03  
EASTING: 872,009.68

FIELDS

FIELDS



**Austin Engineering LLC**

4211 HWY 81 E, LANCASTER, WI 53813  
PHONE 608-723-6363 FAX 608-723-6702

JOB NUMBER 08S002  
FIELDBOOK: TDSR, 2910  
G:\T1NR1W\T1NR1W  
H:\TIE\T1NR1W\70

DRAWN BY: SW AUSTIN  
APPROVED: LL AUSTIN

NOT TO SCALE